


# T. 9S. R. 1W. W.M.

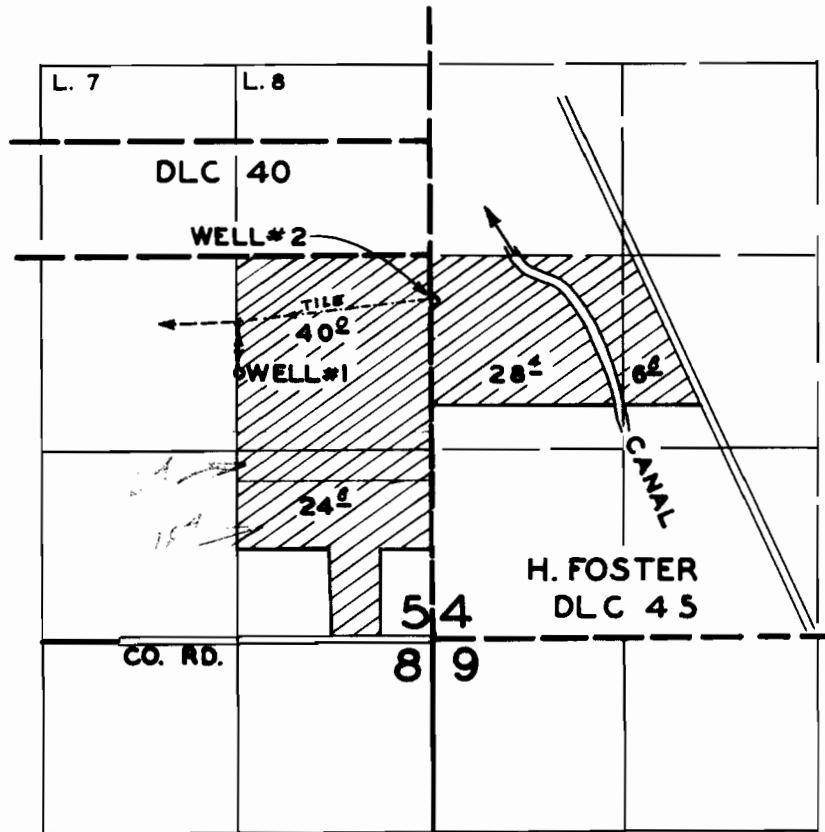

## FINAL PROOF SURVEY UNDER

Application No. G.1050..... Permit No. G.976.....  
IN NAME OF

.....LOUIS HENDRICKS.....

Surveyed MAY 19..... 1960., by C. O. BARTELS.....