


T8S RIW WM

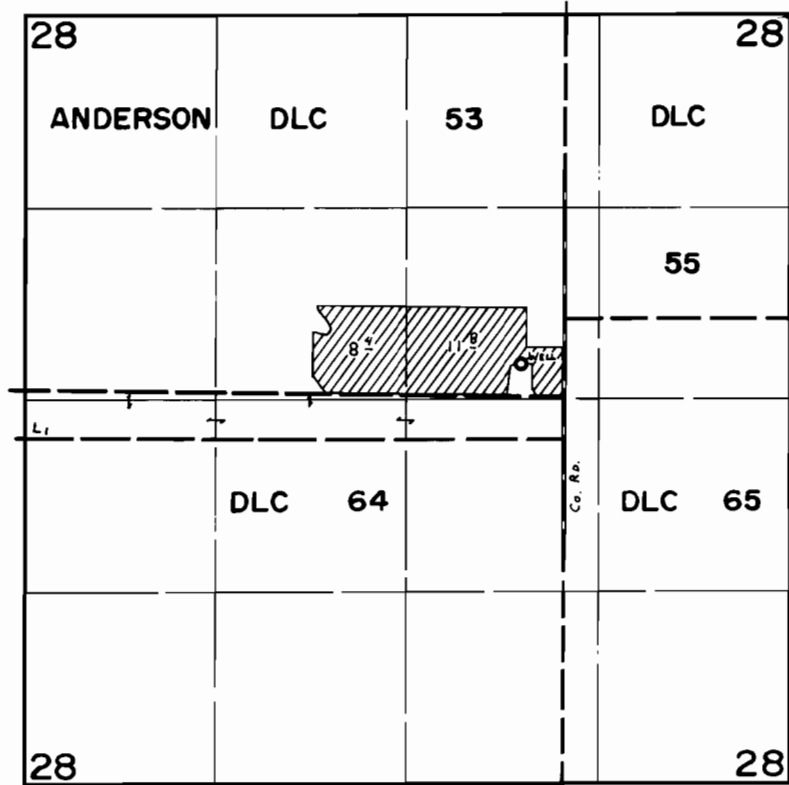

WELL LOC: 220' N. & 290' W. fr. S.E. COR. D.L.C. 53.

FINAL PROOF SURVEY UNDER

Application No. G-7054 Permit No. G-6371....
IN NAME OF

GEORGE J GERSPACHER

Surveyed Apr. 25 1980, by C. L. Hughes