


T. 6S., R. 1W., W.M.

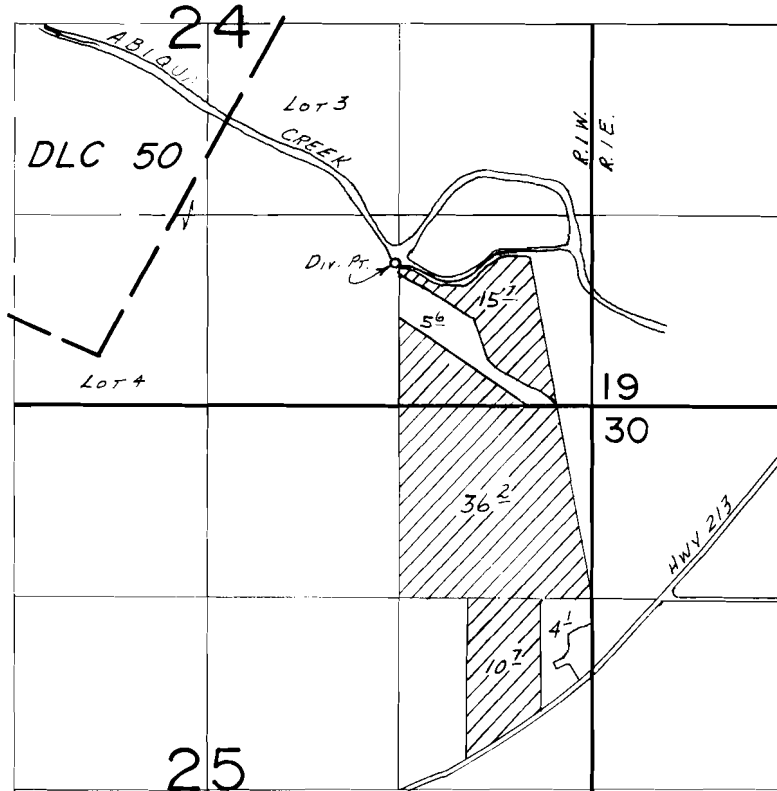

Div. Pt. Loc.: 980' N. & 1350' W. FROM SE COR. SEC. 24.

SCALE: 1" = 1320'

FINAL PROOF SURVEY UNDER

Application No. 57582... Permit No. 43312.....
IN NAME OF

.....DAVID J. BIELENBERG.....

Surveyed May 30... 1984, by B.W. BISHOP.....