


T.I.S.R. 4E.W.M.

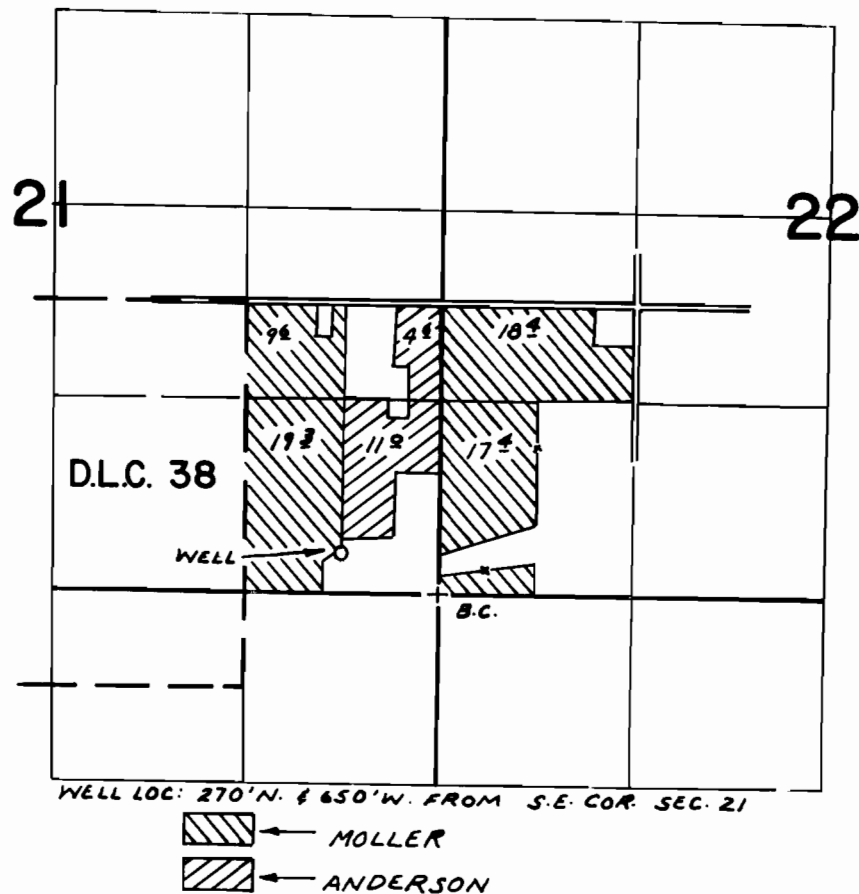

FINAL PROOF SURVEY UNDER

Application No. G-7082 Permit No. G-6553
IN NAME OF

MOLLER'S NURSERY, INC.

Surveyed JAN. 7, 1980, by R.G. MUCKEN