


T. 1N., R. 32E., W.M.

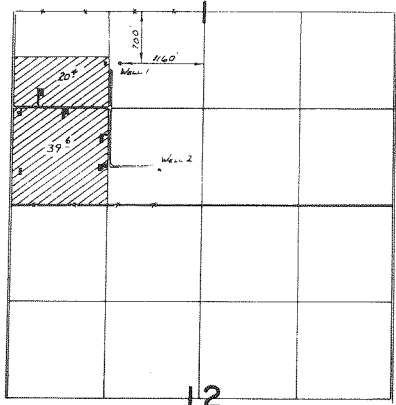

**FINAL PROOF SURVEY  
UNDER**

Application No. G-3783 Permit No. G-3568  
IN NAME OF

**RALEY F. PETERSON & MICHAEL J. KILBY**

Surveyed 11:26 1982, by *J.L. Chavel*