


65593⁵

53251

T. 2N., R. 32E., W. M.

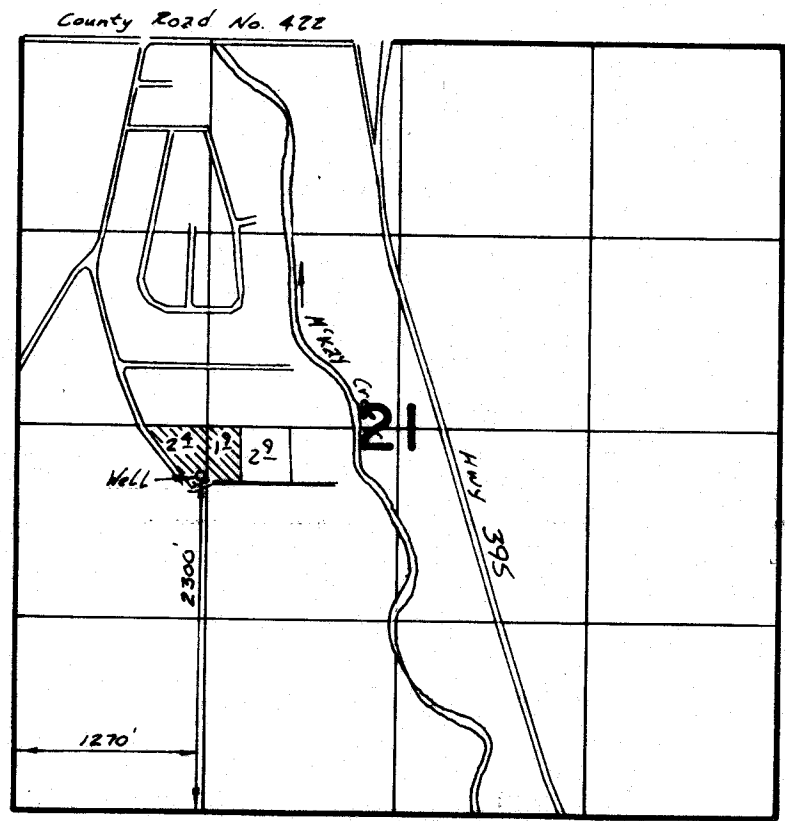

FINAL PROOF SURVEY
UNDER

Application No. G-5855 Permit No. G-5593...
IN NAME OF

..... *Don R. Hill*

Surveyed *May 11*, 1982, by *V. Church*.....