


G 5660⁵

53252

T. 2N., R. 32E., W.M.

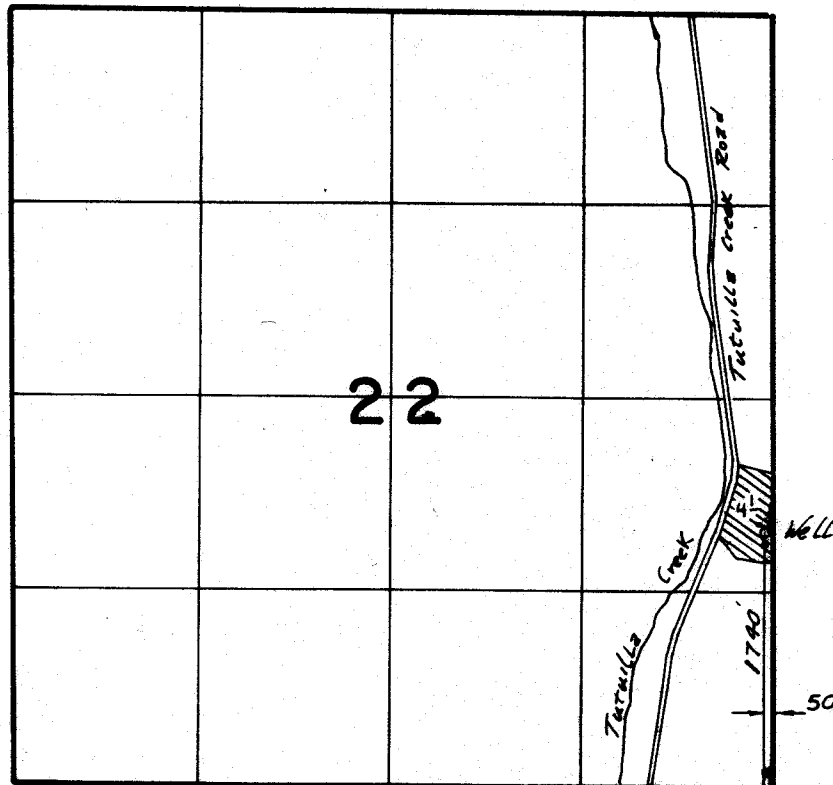

SCALE: 1" = 1320'

FINAL PROOF SURVEY
UNDER

Application No. 4-5970. Permit No. 4-5660....
IN NAME OF

.....STEVE.....WEST.....

Surveyed May 16, 1982, by J. Chmurski.....

Revised April, 1985
VLC
74-2