


T. 1S. R. 32E. W.M.

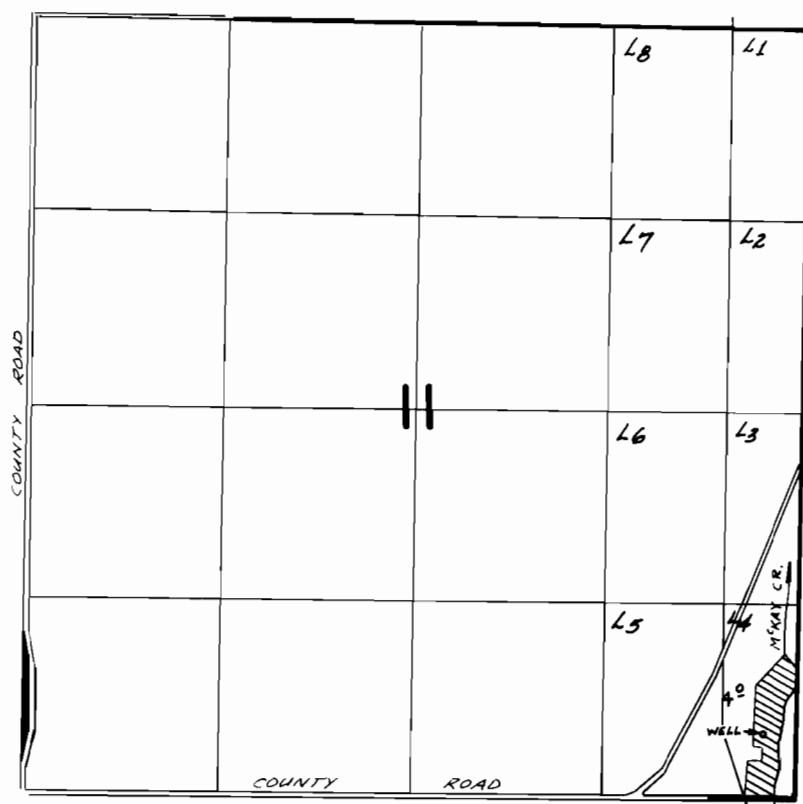

WELL LOC. 440'N & 220'W FROM SE COR. SEC 11

FINAL PROOF SURVEY
UNDER

Application No. G-7610 Permit No. G-7057
IN NAME OF

FRED C. HOEFT

Surveyed 3-30 1978, by R. BARWIN