# T. 4N., R. 28E., W.M.

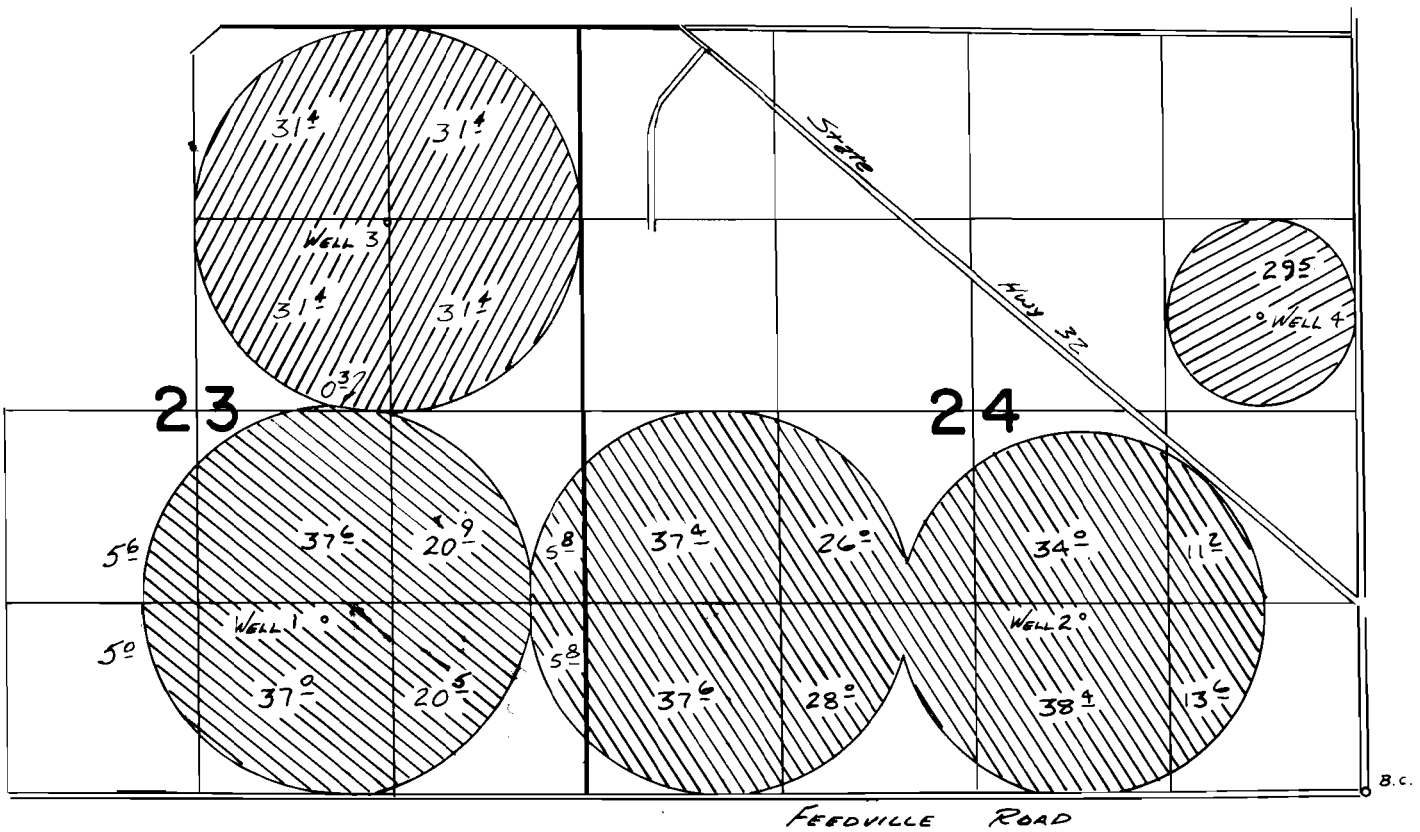


Well 1 Loc: 1210'N. & 1800'W. From SE Cor. Sec 23

Well 2 Loc: 1230'N. & 1910'W. From SE Cor. Sec 24

Well 3 Loc: 1350'S. & 1330'W. From NE Cor. Sec 23

Well 4 Loc: 660'N. & 670'W. From E¼ Cor. Sec 24

## FINAL PROOF SURVEY

UNDER

Application No. G-7851 Permit No. G-7183

IN NAME OF

VERNON & IVAN COOK

Surveyed 5-13 1982, by [illegible]

223R 222L