


G 1975

53256

T. 4N. R. 35E. W.M.

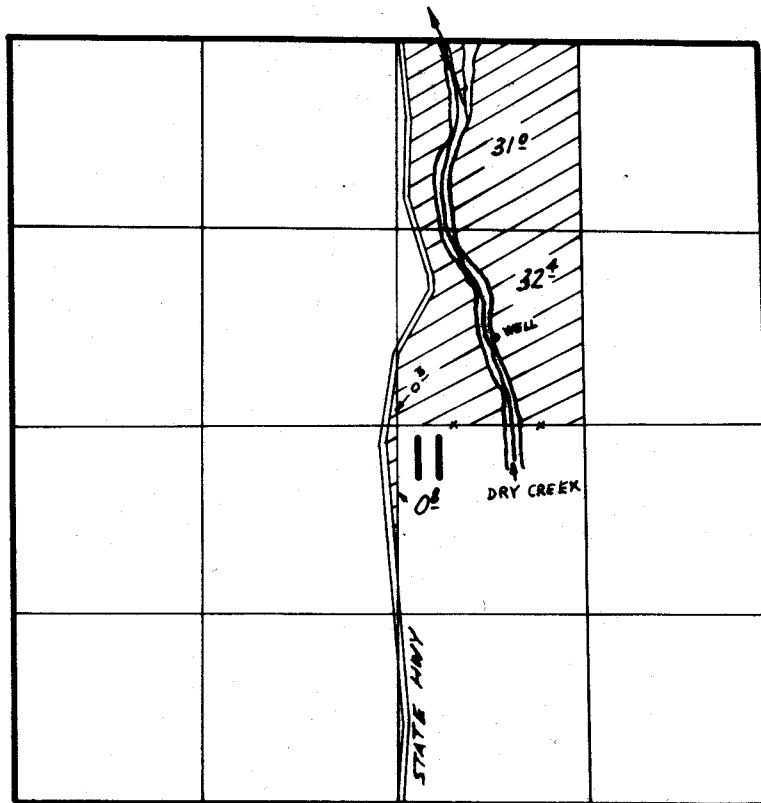

WELL LOCATED : 600' N. & 680' E. from Center 1/4 Cor. Sec. 11

FINAL PROOF SURVEY
UNDER

Application No. G-8671 Permit No. G-7975
IN NAME OF

GEORGE R. WINN

Surveyed 7-18 1978, by R. BARWIN