G8149

53257

5

T. 2N., R. 31 & 32E., W. M.

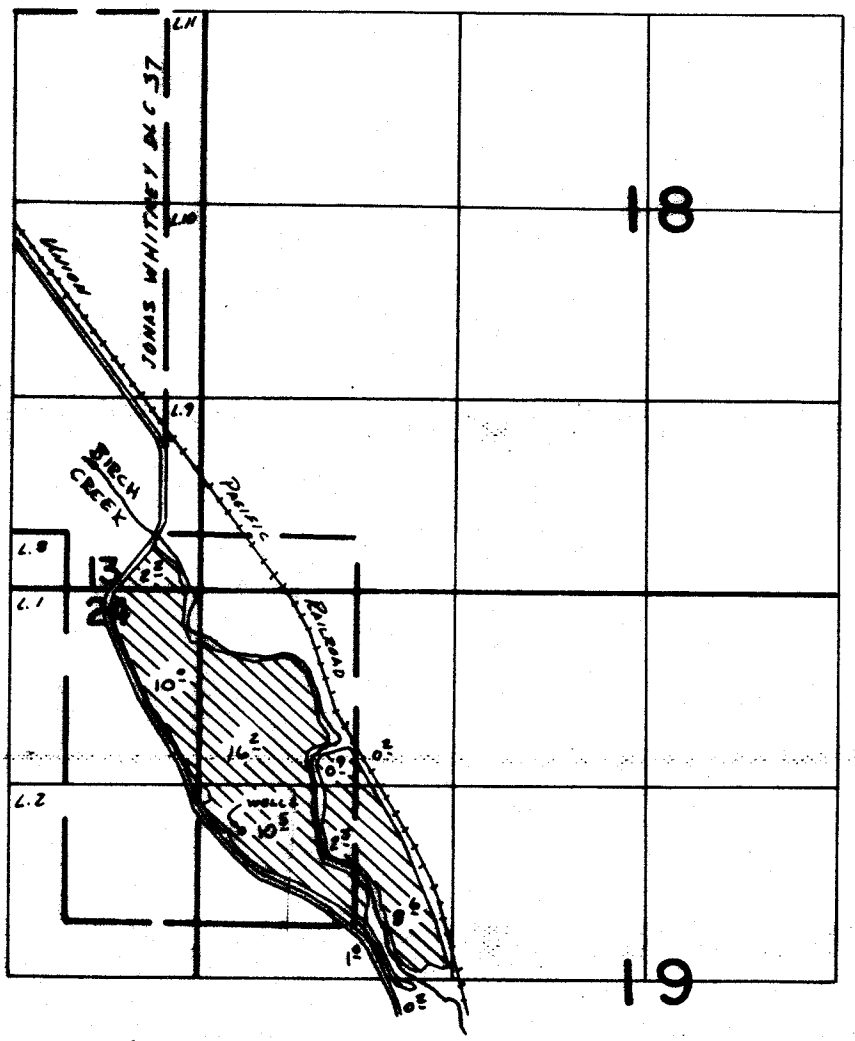

WELL LOCATED 1650'S. & 300'E. FROM NW COR SECTION 19

FINAL PROOF SURVEY
UNDER

Application No. G8666 Permit No. G8149
IN NAME OF

JAMES E. McBROOM

Surveyed ..... 19..., by .....

72R
NZ-2MM-128
PTS-1978-P-A 1-16-84