


# T 4 N. R. 29 E. W. M.

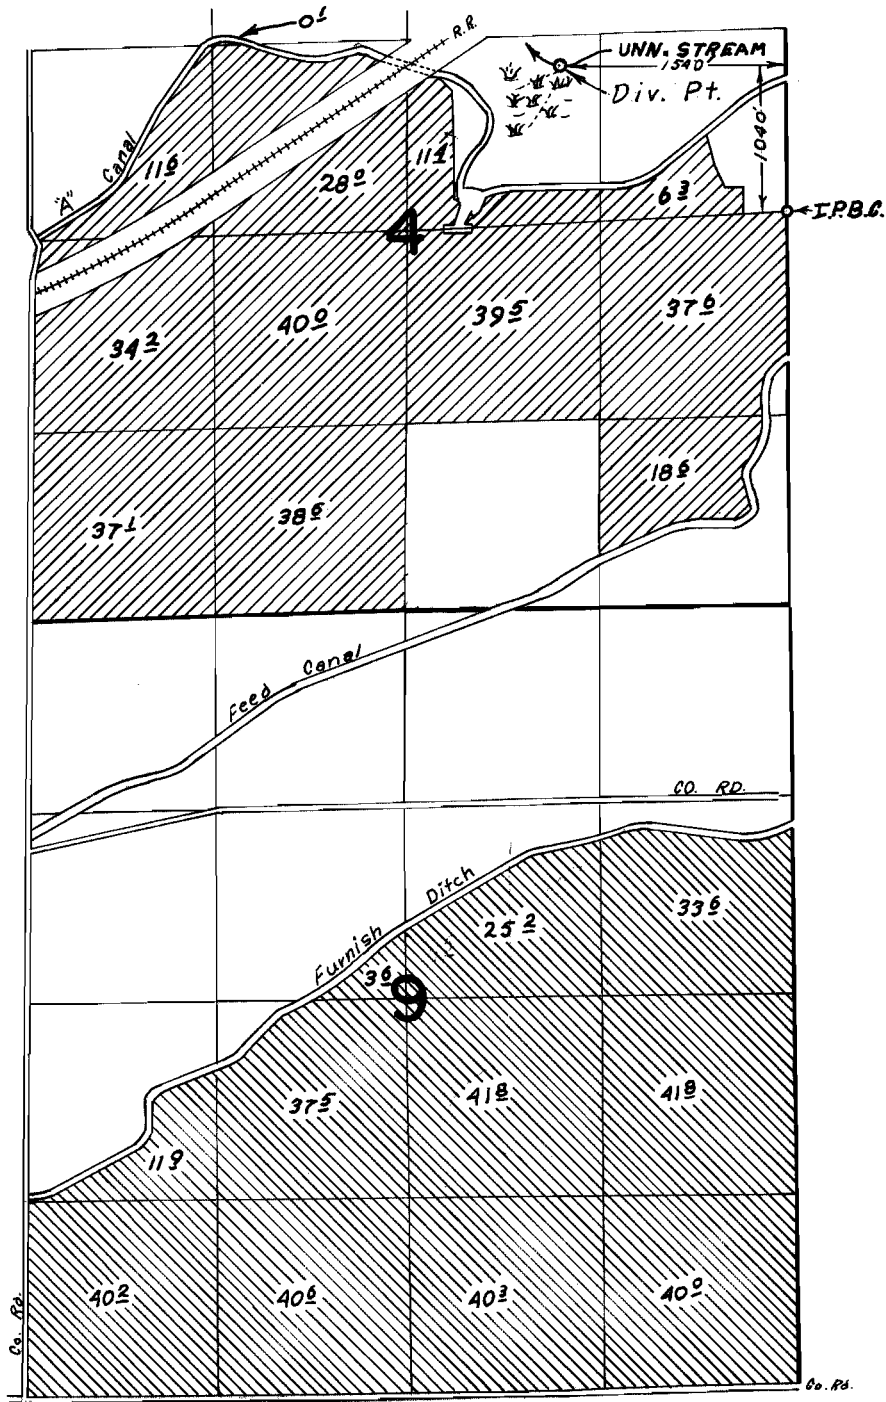

## FINAL PROOF SURVEY UNDER



SUPPLEMENTAL

PRIMARY

Application No. 40535... Permit No. 30373...  
IN NAME OF

JOHN F. WALCHLI

Surveyed AUG. 30. 1971., by L. E. Gould