


G-8694

T.2N. R.12E. W.M.

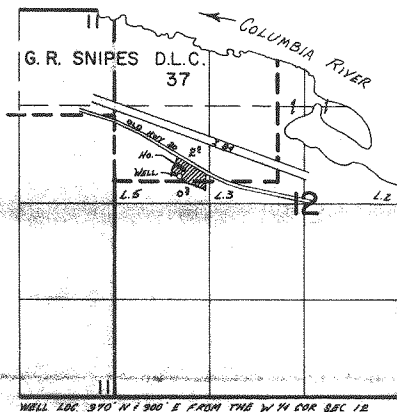

FINAL PROOF SURVEY UNDER

Application No. G-9424. Permit No. G-8694.
IN NAME OF

GENE ADKISSON

Surveyed Nov. 4, 1983, by T. J. Paul