
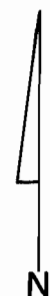


T. 2 S., R. 4 W., W.M.

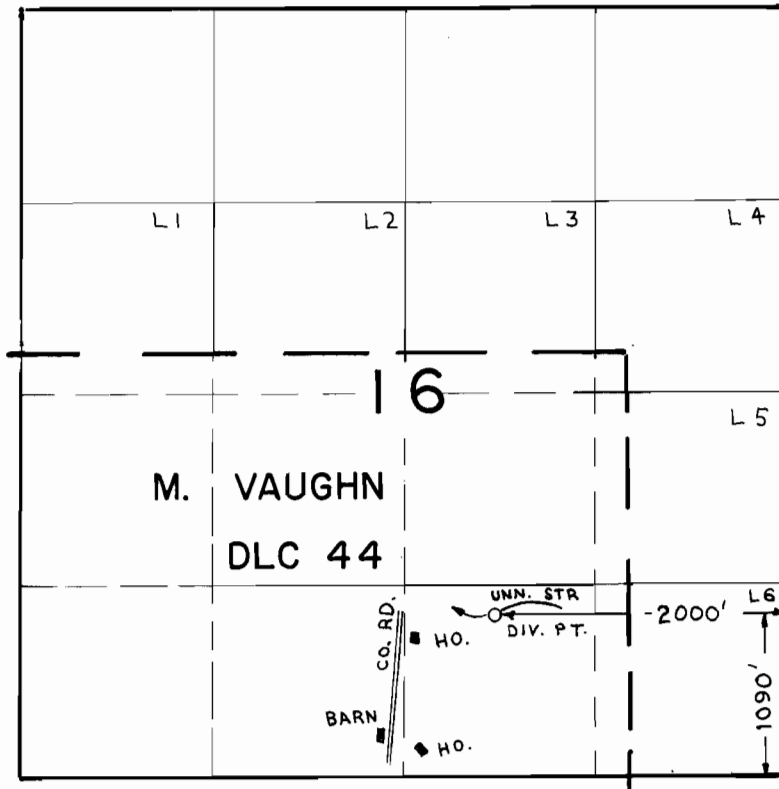

SCALE
1" = 1320'

FINAL PROOF SURVEY
UNDER

Application No. 61786 Permit No. 45986
IN NAME OF

CHESTER E. BARRETT

Surveyed AUG 22, 1984, by P. PAGTER