


# T. 4 S., R. 4 W. WM

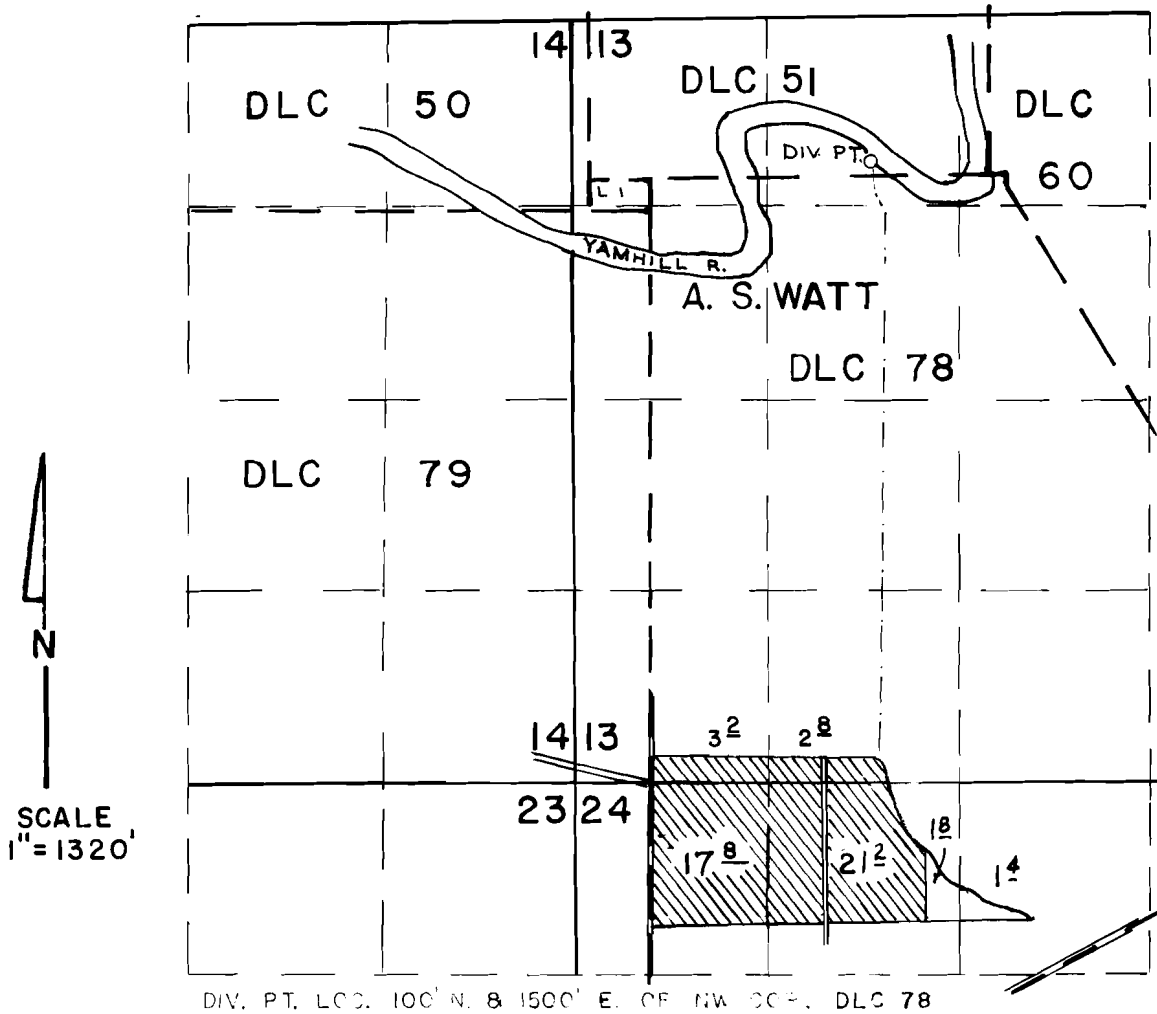

## FINAL PROOF SURVEY UNDER

Application No. ~~58426~~ Permit No. ~~46425~~.....  
IN NAME OF

STANLEY K. & DORA H. BANSEN

Surveyed JUN 19 1984, by P. PAGTER.....