


T. 3S., R. 1W. & 1E., W.M.

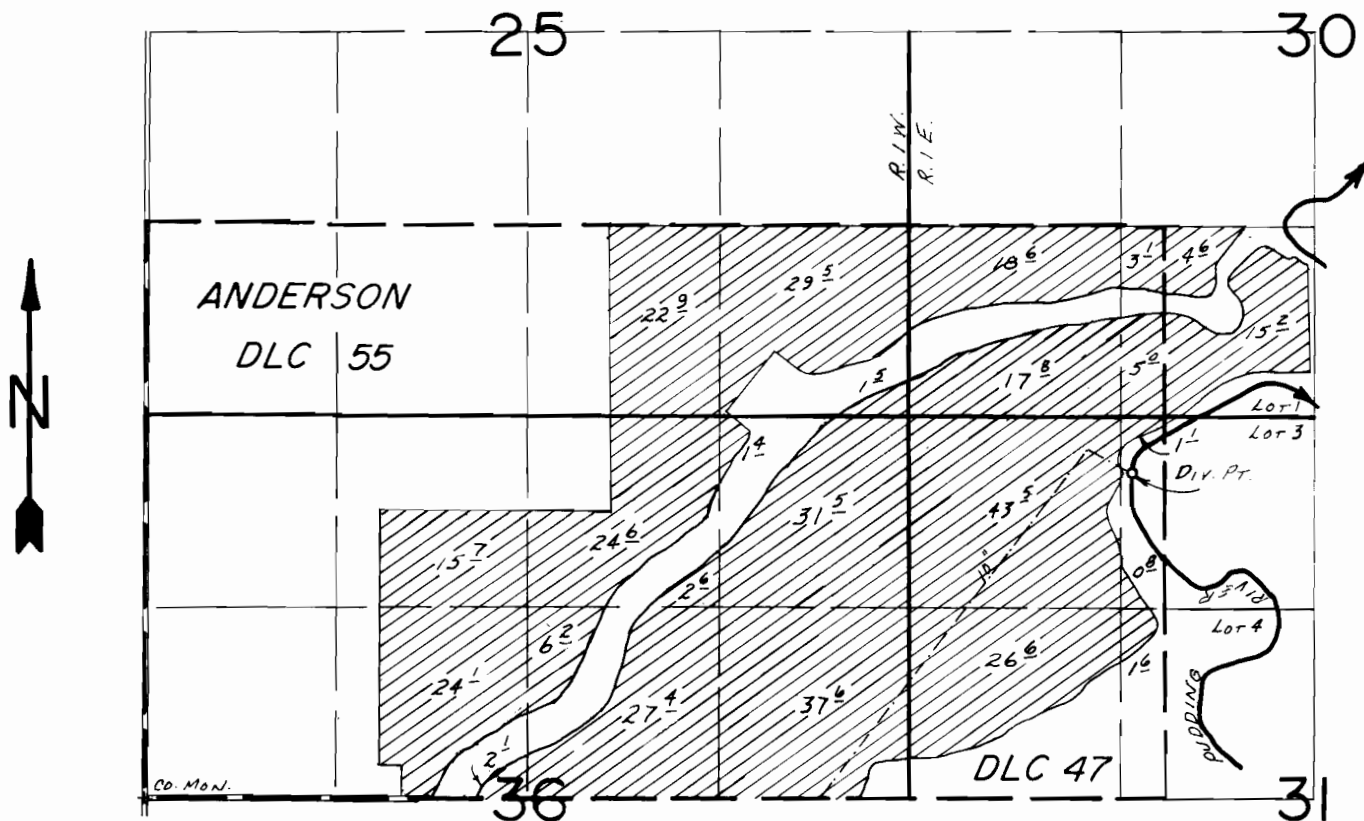

Div. Pt. Loc. : 1700 S.  $\frac{1}{4}$  230' W. FROM NE COR. ANDERSON DLC 47

SCALE : 1" = 1320'

**FINAL PROOF SURVEY**  
UNDER

Application No. 24626. Permit No. 19470...  
IN NAME OF

O. O. OGDEN

Surveyed May. 16... 19.56, by R.D. BEST.....