


T.24S. R.12W. W.M.

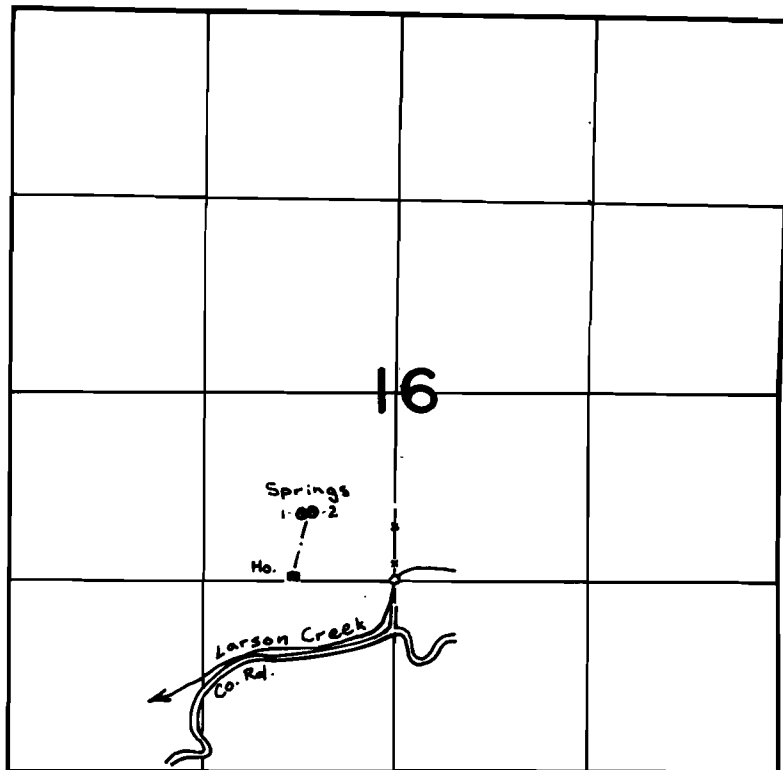

Springs Located: 1- 470'N & 630'W; 2- 480'N & 560'W
both from the SE cor. NE 1/4 SW 1/4 Sec. 16

SCALE: 4" = 1mi.

FINAL PROOF SURVEY
UNDER

Application No. 55707 Permit No. 41726
IN NAME OF

BUD R. & YVONNE BUCKLES

Surveyed March 8 1978, by D. Sparks