T. 28S. R. 14W. W.M.

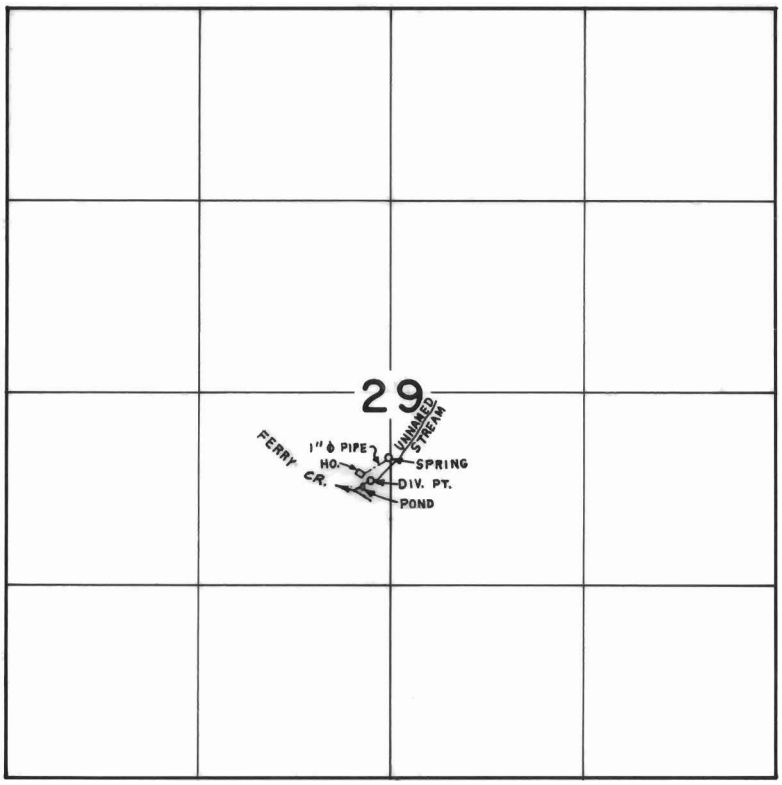

SPRING LOCATED 445' S. & 10' W. FROM C. 1/4 CORNER SECTION 29
DIV. PT. LOCATED 600' S. & 140' W. FROM C. 1/4 CORNER SECTION 29

SCALE: 4" = 1 mile

FINAL PROOF SURVEY

UNDER

Application No. R-58618 (58341) Permit No. R-7834 (44252)

IN NAME OF

HOWARD CUNNINGHAM

Surveyed NOV. 2, 1983, by L. CASHION

41011 180 12D ¢ PTS 1983 RA D.K.C.