
T. 28S. R.14W. W.M.

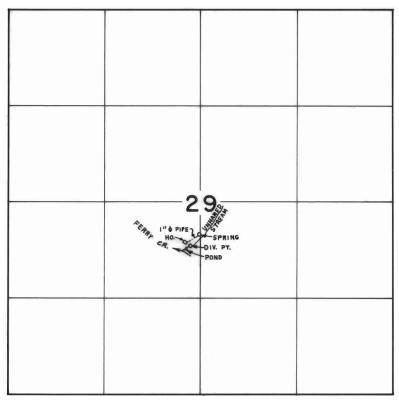

SPRING LOCATED 445'S \$ 10'W. FROM C. 1/4 CORNER SECTION 29
DIV. PT. LOCATED 600'S. & 140'W. FROM C. 1/4 CORNER SECTION 29

SCALE: 4"= Imile

FINAL PROOF SURVEY

UNDER

58341 44252 Application No. R-58618 Permit No. R-7834 IN NAME OF

HOWARD CUNNINGHAM

Surveyed NOV. 2. 1983, by L. CASHION