


T. 28S., R. 14 W., W.M.

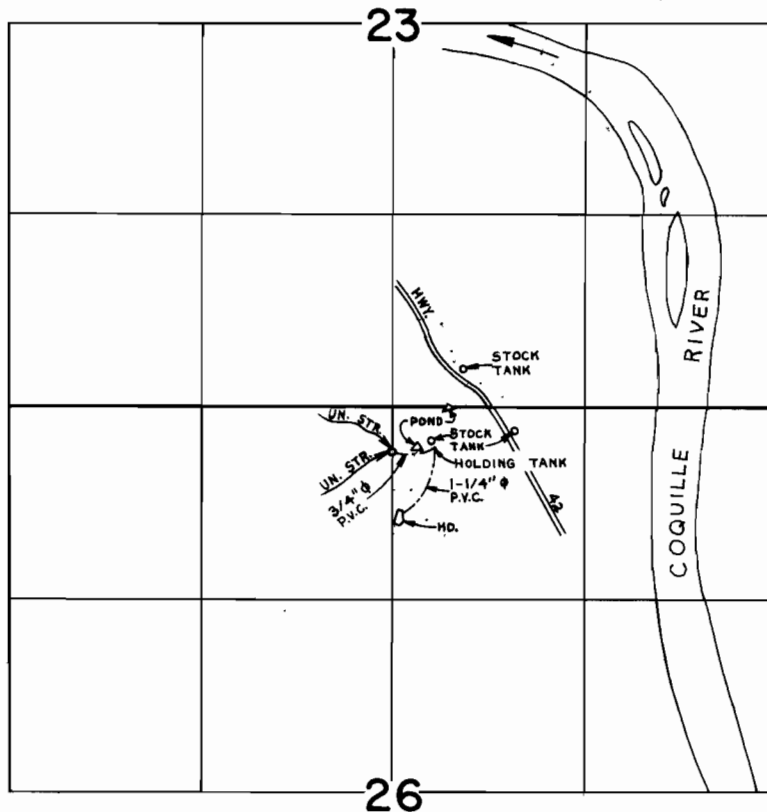

DIV. PT. LOCATED 305'S. FROM N. 1/4 CORNER SECTION 26

SCALE: 4" = 1 mile

FINAL PROOF SURVEY UNDER

Application No. 65514... Permit No. 47773...
IN NAME OF

.....**EARL CLAMPETT**.....

Surveyed SEPT. 10, 1984, by L. CASHION.....