


T. 27S., R. 7W., W.M.

SEC. 26

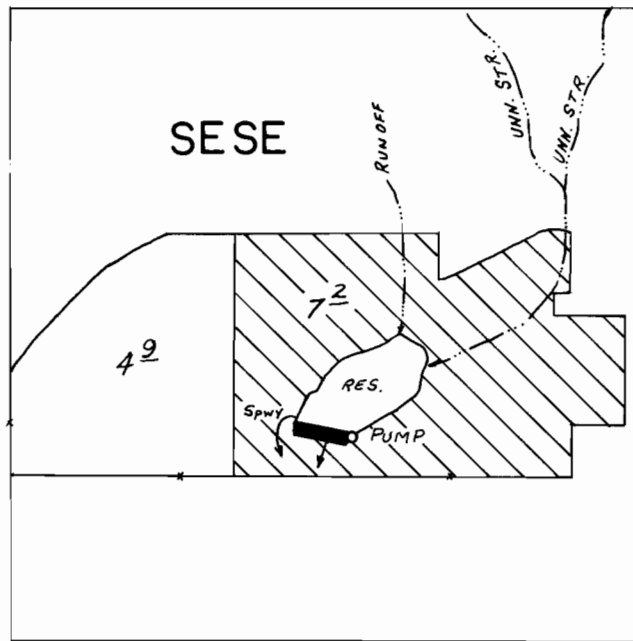

Div. Pt. Loc.: 430' N. & 660' W. FROM SE COR SEC. 26.

SCALE: 1" = 400'

**FINAL PROOF SURVEY**  
UNDER

R-49754                      R-6045  
Application No. 49755    Permit No. 37254  
IN NAME OF

AUGUST E. STUBER

Surveyed APR. 2, 1980, by J.S. DONALDSON