


T. 1 N. R. 21 E. W. M.

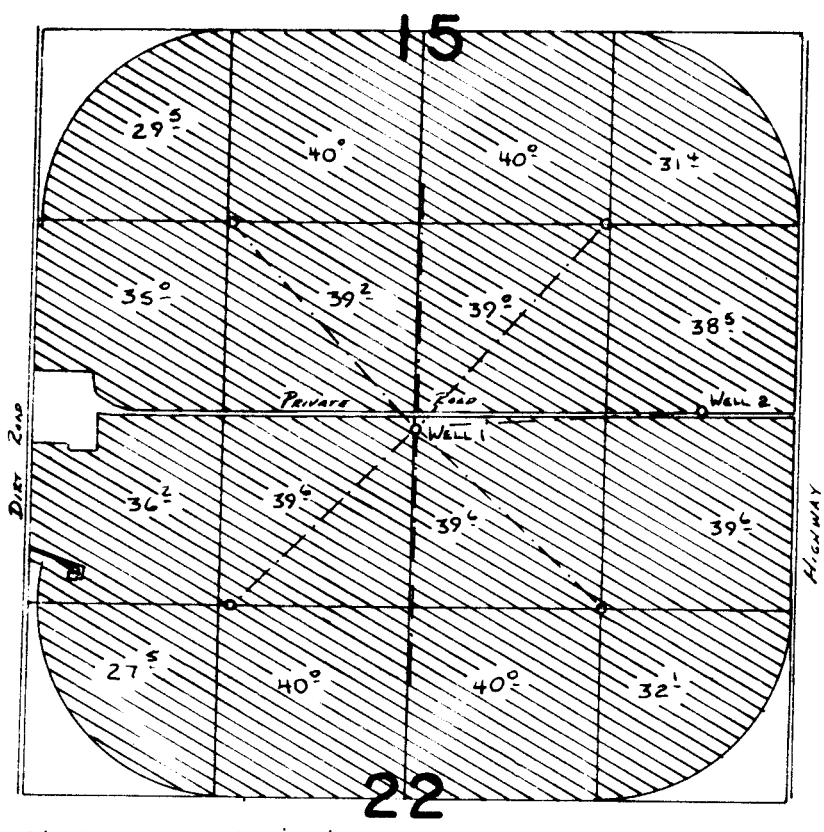

Well 1 Located 80'S. & 10'E. FROM NW 4 COR. SECTION 22
 Well 2 Located 50'N. & 190'E. FROM S 1/4 COR. SECTION 15

SCALE: 1" = 1320'

FINAL PROOF SURVEY UNDER

Application No. G-9432. Permit No. G-8800....
 IN NAME OF

.....A. DAVID & PEGGY S. CHILDS.....

Surveyed 5-2-1985, by V. J. Church.....