


C-53319

G-9186

T.10S. R.29E. W.M.



SCALE: 1"=1320'

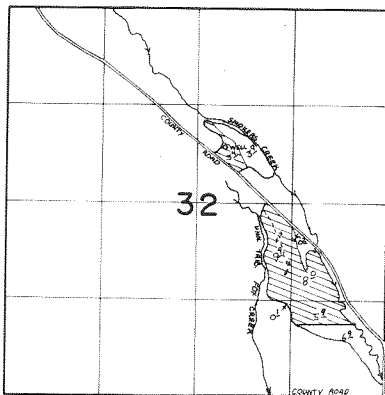

WELL LOCATED 3380' N. AND 2240' W. FROM THE SE. COR. SEC. 32

FINAL PROOF SURVEY

UNDER

Application No. G-9740, Permit No. G-9186.....
IN NAME OF

JACK E. JOHNS — VAUGHAN RANCH

Surveyed Aug. 6, 1981, by P.R. PASTER.....