

Application No. 61919
Permit No. 45938

RECEIVED

JUL 17 1981


WATER RESOURCES DEPT
SALEM, OREGON

T. 38 S., R. 3 W., W.M.

RECEIVED

AUG 17 1981

WATER RESOURCES DEPT
SALEM, OREGON

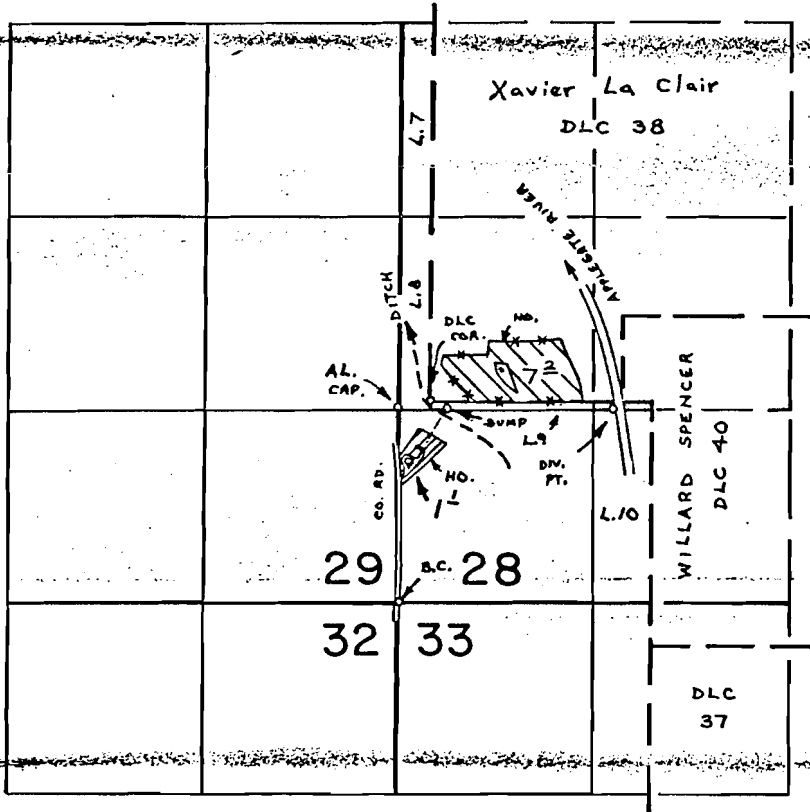

DIV. PT. LOC. - 1320' N. & 1450' E. FROM S.W. COR., SEC. 28.

Map to accompany application of P. K. and/or Jean C. Richardson to appropriate storage water from Applegate Lake Reservoir constructed under Permit No. R-7810 to supplementally irrigate the above acreage with 11.0 acre feet of storage water.

FINAL PROOF SURVEY
UNDER

46969

35143



Application No. 52404 Permit No. 39419

IN NAME OF

P.K. & MURIEL RICHARDSON

Surveyed JUN. 13 & 14 78 by B. SUND

D.H.M.

P.T.S. - 1978-14-A