

RECEIVED ^{95.}

AUG 4 1981


WATER RESOURCES DEPT
SALEM, OREGON

T. 38 S., R. 3 W., W.M.

RECEIVED

MAY 29 1981

WATER RESOURCES DEPT
SALEM, OREGON

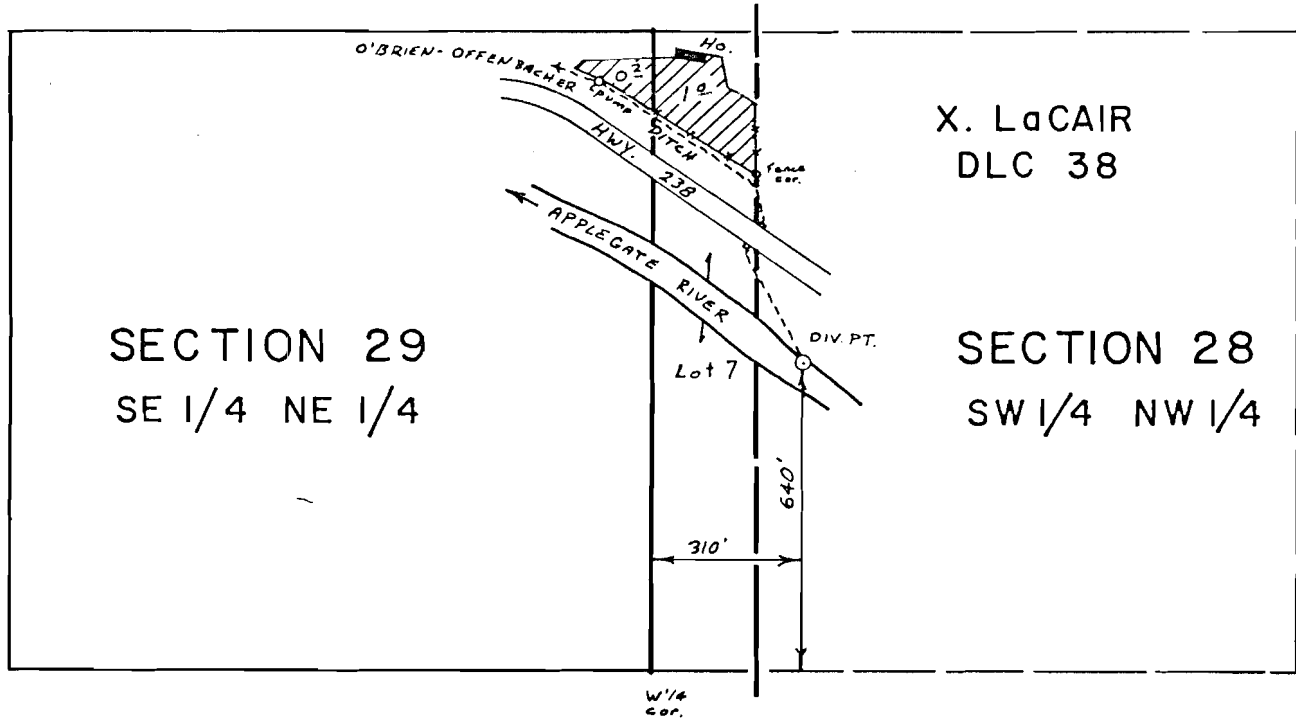

Scale 1" = 400'

SURVEY

UNDER

Map to accompany application for storage water from the Applegate Dam in the amount of 2 acre feet to supplementally irrigate the above described 1.2 acres.

Application No. 53331... Permit No. 39572...

IN NAME OF

LEONARD G. & DIANA M. VERMEULEN

Application No.
Permit No.

61735
Surveyed MAY 11, 1979, by B.R. SUND.....

45876