


T. 13 S., R. 9 E., W.M.
SECTION 15

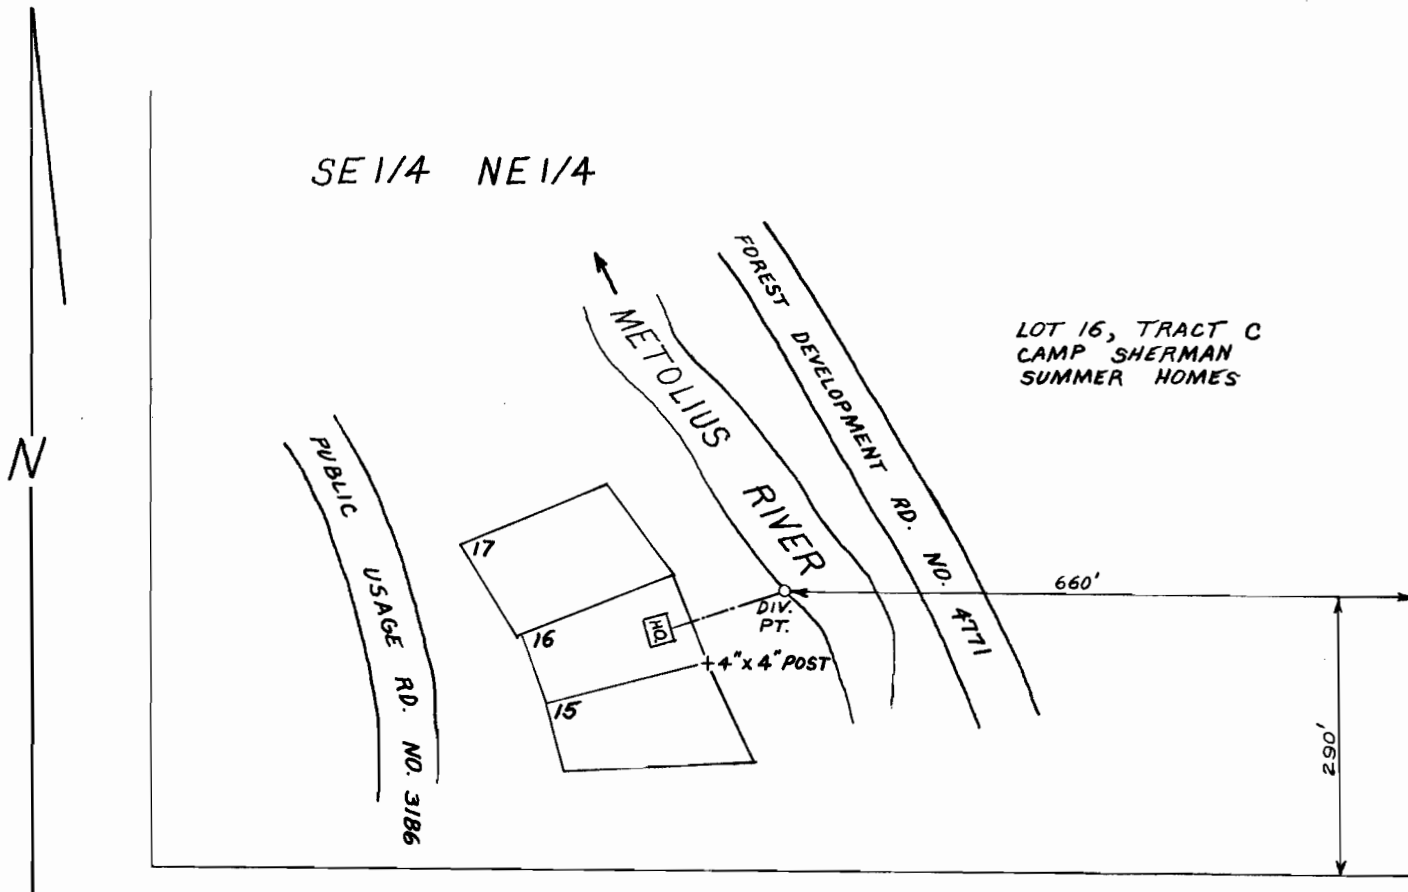

SCALE: 1" = 200'

FINAL PROOF SURVEY

UNDER

Application No. 64843 Permit No. 47768

IN NAME OF

DONALD J. &/or. JANE M. SPARKS

Surveyed APRIL 3 19 85, by LESLIE OLSON