


T. 13S., R. 9 E., W.M.  
SECTION 3

FILED

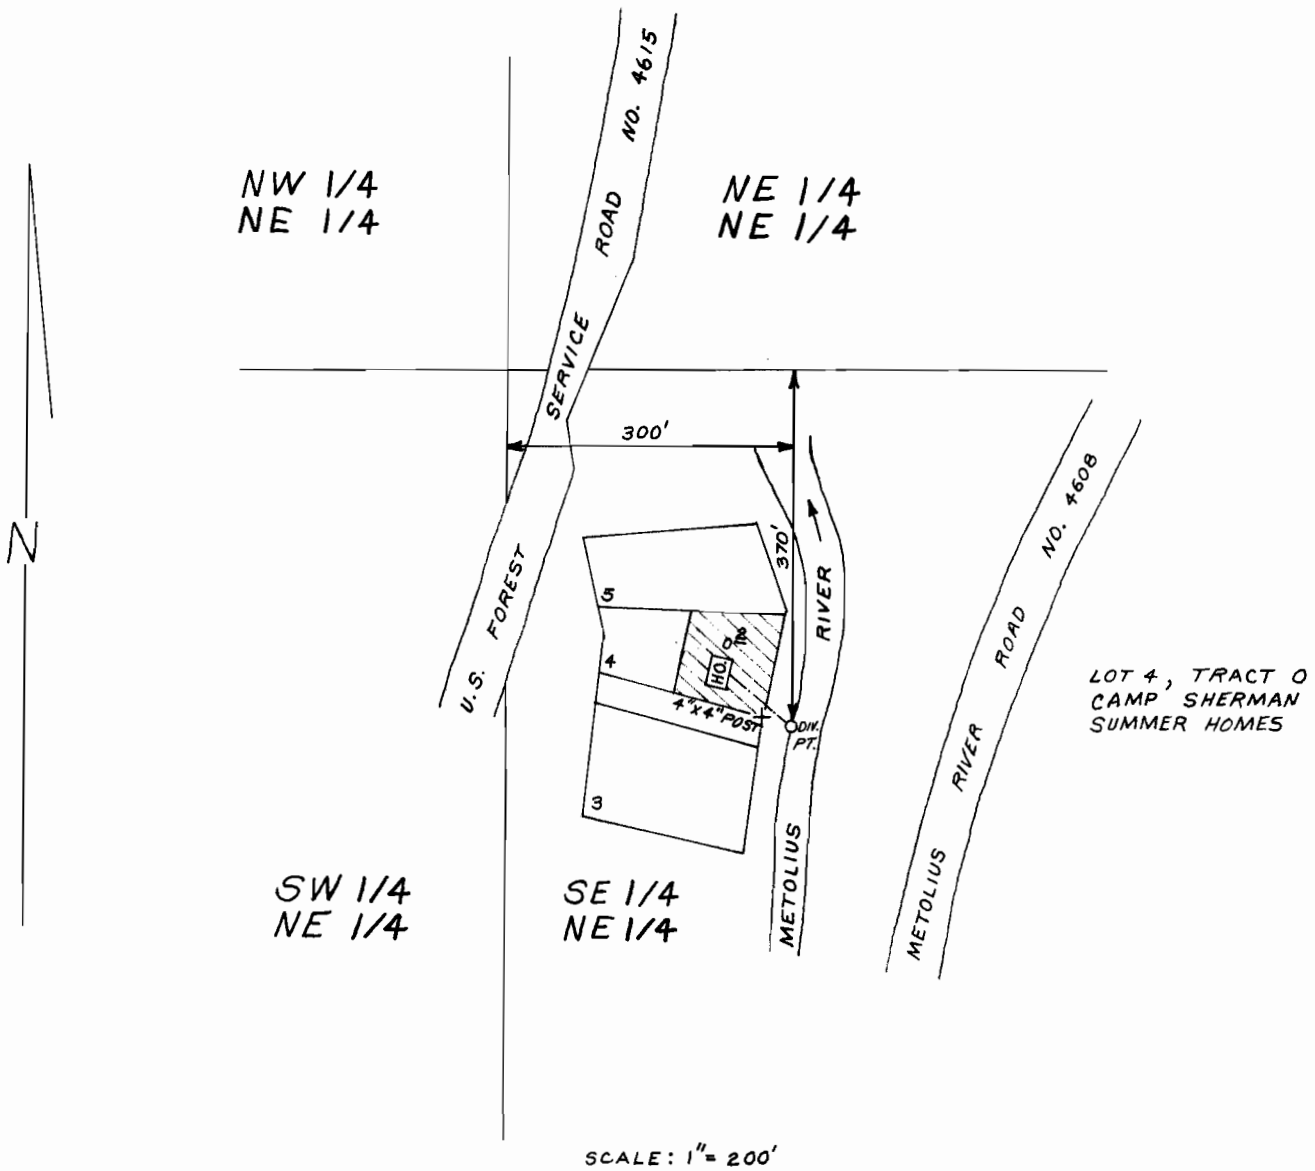

FINAL PROOF SURVEY  
UNDER

Application No. 64945 Permit No. 47830

IN NAME OF

JOSEPH H. JR. & FRANCES G. RUDD

Surveyed MAY 1, 19 85, by LESLIE OLSON