


# T. 13 S., R. 9 E., W.M.

## SECTION 3

RECEIVED  
MAY 25 1985  

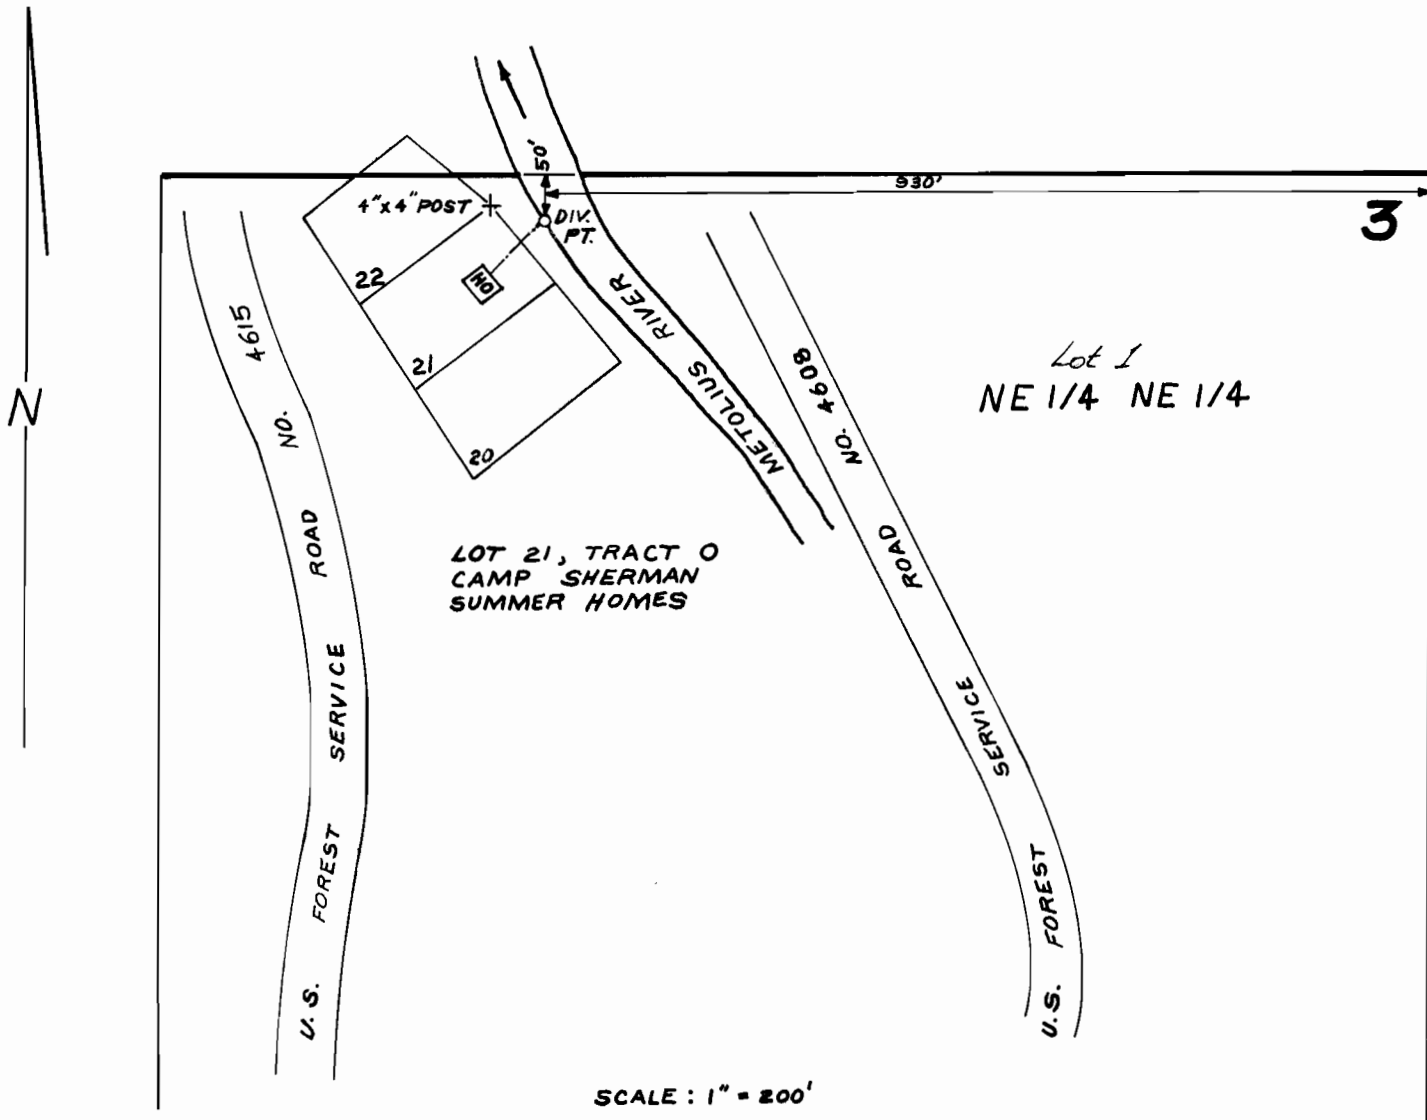

### FINAL PROOF SURVEY

UNDER

Application No. 65275 Permit No. 47904

IN NAME OF

JESSE N. & MARGUERITE R. BUTLER

Surveyed MAY 1 19 85, by LESLIE OLSON