


T. 13 S., R. 9 E., W.M.

SECTION 10

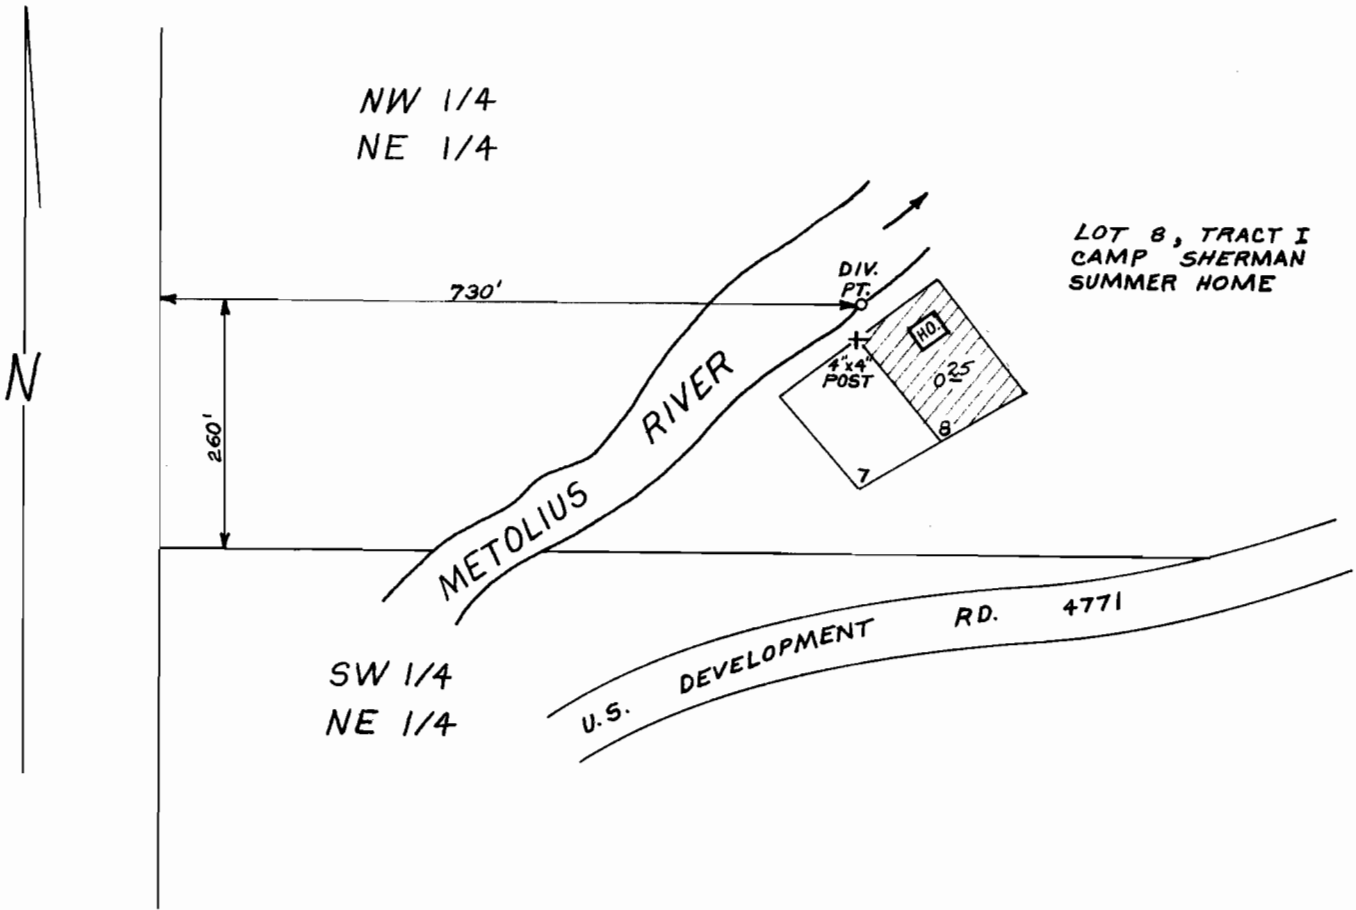

SCALE: 1" = 200'

FINAL PROOF SURVEY

UNDER

Application No. 67433 Permit No. 48318

IN NAME OF

CHAPIN D. CLARK

Surveyed MAY 1 19 85, by LESLIE OLSON