


T. 13 S., R. 9 E., W.M.

SECTION 3

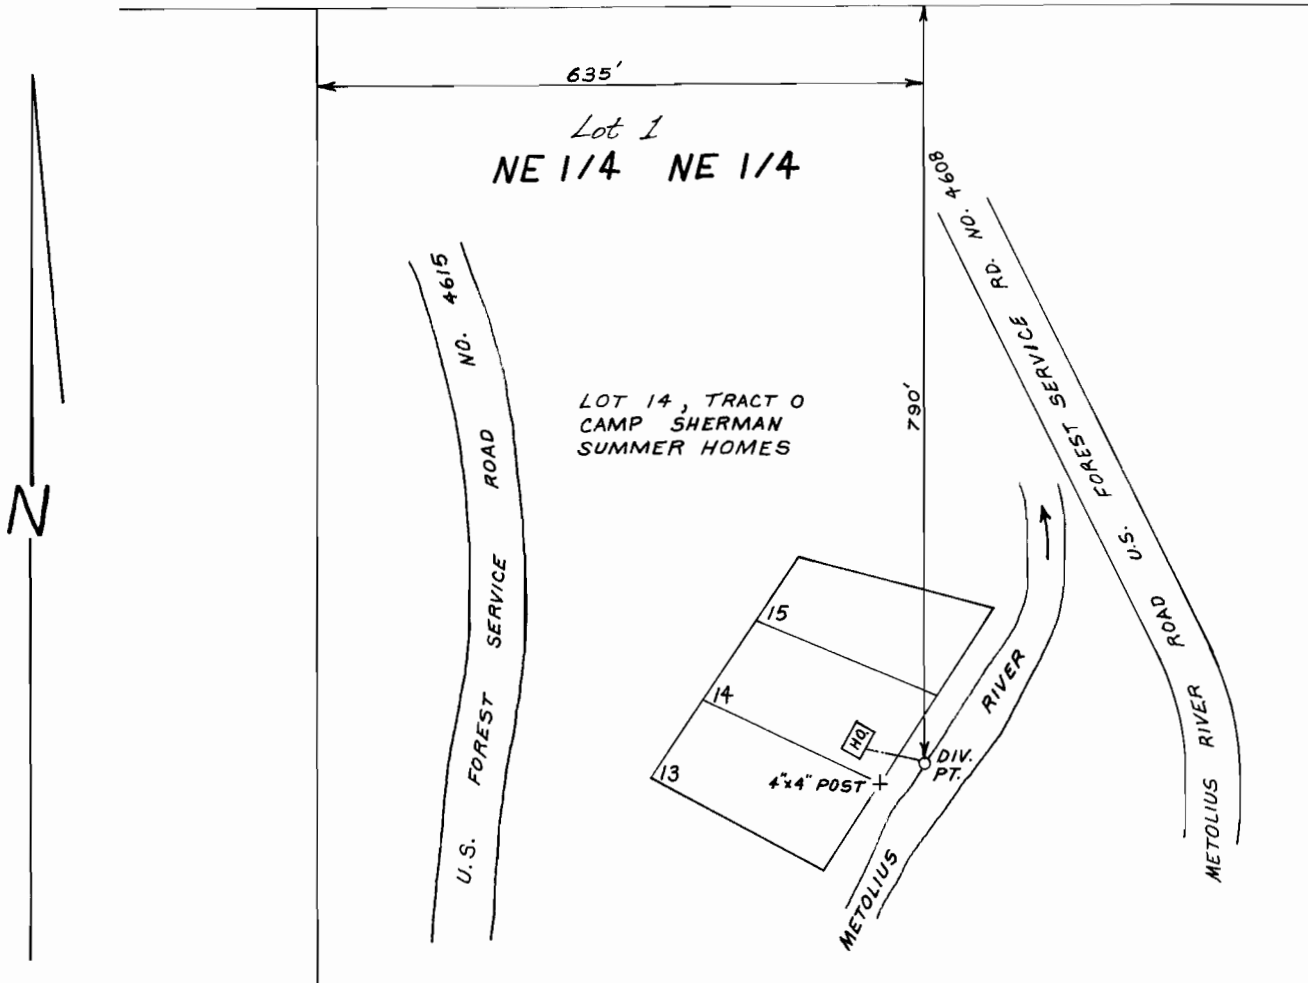

SCALE: 1" = 200'

FINAL PROOF SURVEY

UNDER

Application No. 65489 Permit No. 47972

IN NAME OF

SCOTT REDFIELD

Surveyed MAY 1 19 85, by LESLIE OLSON