


T. 13 S., R. 9 E., W. M.

SECTION 15

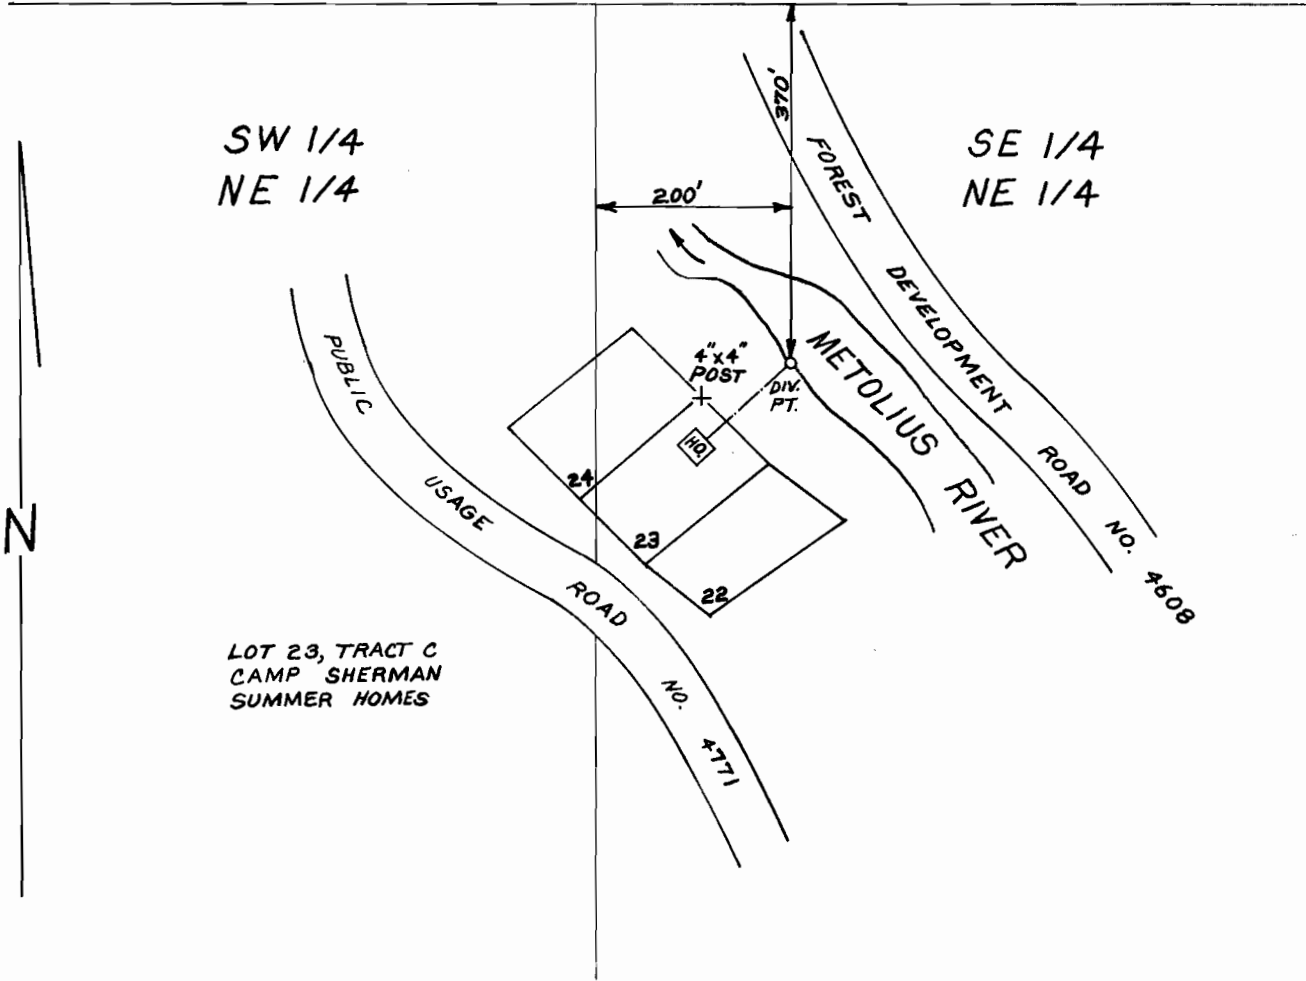

SCALE: 1" = 200'

FINAL PROOF SURVEY

UNDER

Application No. 64616 ... Permit No. 47498

IN NAME OF

MELVIN T. & CAROL N. NYGAARD

Surveyed APRIL 3, 1985, by LESLIE OLSON