


T. 13 S., R. 9 E., W.M.

SECTION 15

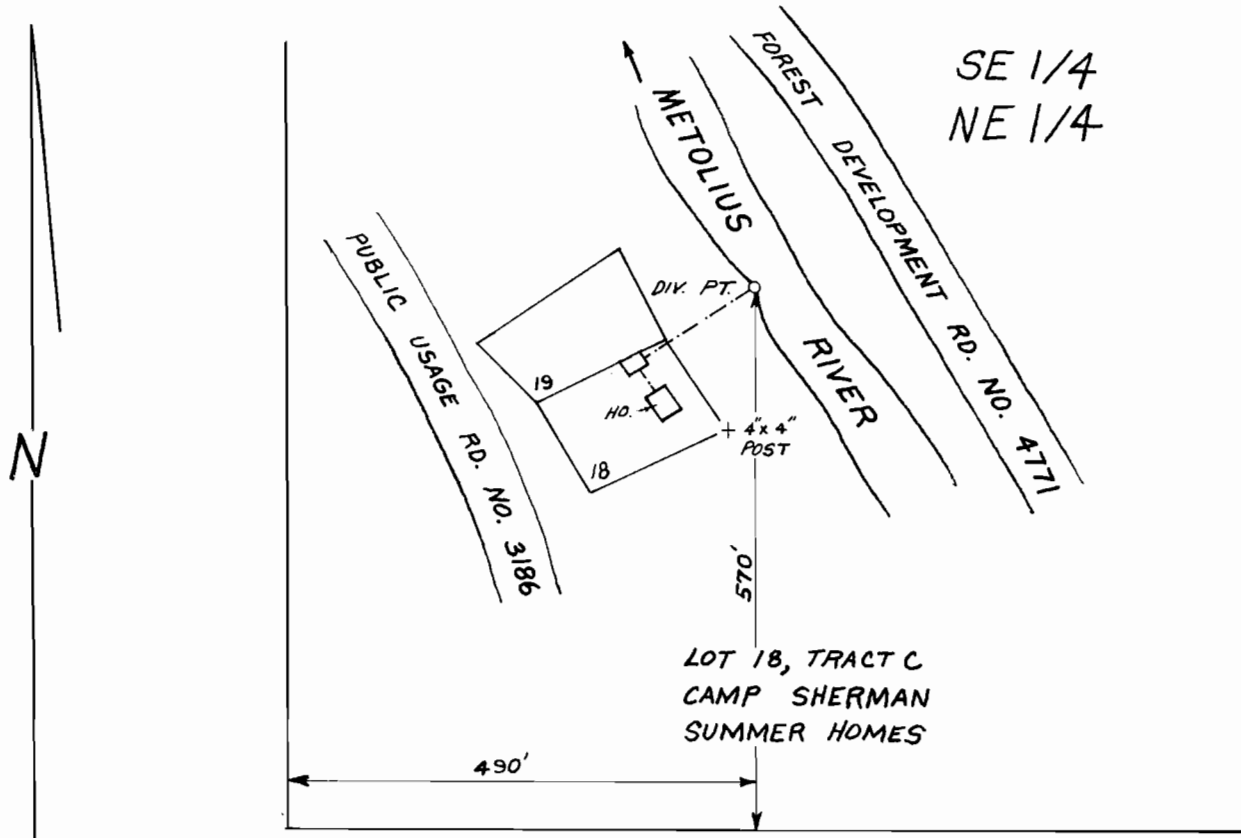

SCALE: 1" = 200'

FINAL PROOF SURVEY

UNDER

Application No. 65483 Permit No. 48866

IN NAME OF

WILLARD & CHRISTINE BONE

Surveyed APRIL 30, 1985, by LESLIE OLSON