


T. 13 S., R. 9 E., W. M.

SECTION 15

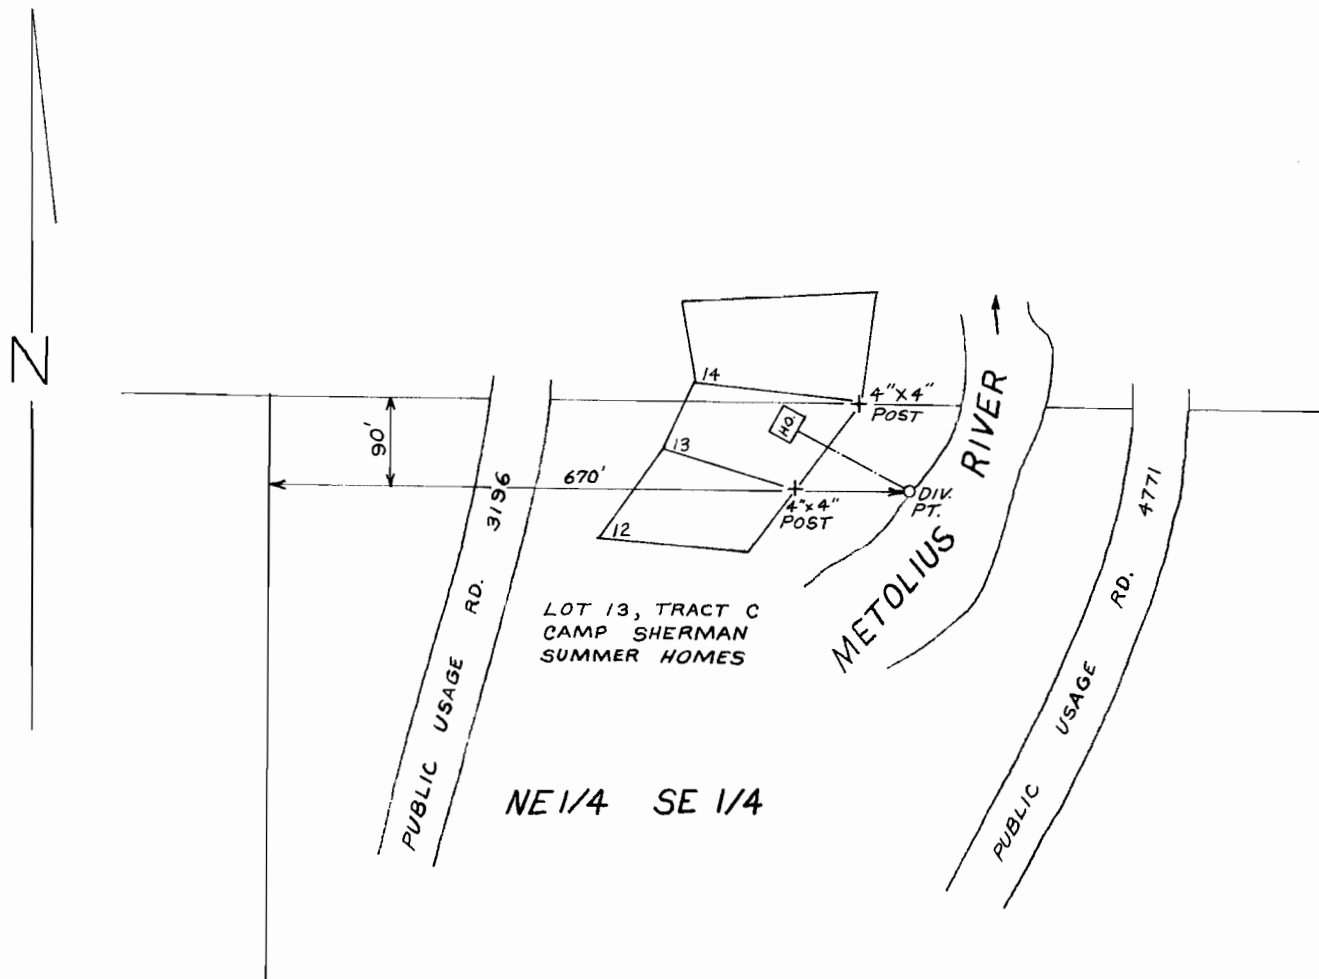

SCALE: 1" = 200'

FINAL PROOF SURVEY

UNDER

Application No. 65490 Permit No. 47973

IN NAME OF

ROBERT J. MATTECHECK

Surveyed APR. 3 19 85, by LESLIE OLSON