


T. 13 S., R. 9 E., W.M.
SECTION 15

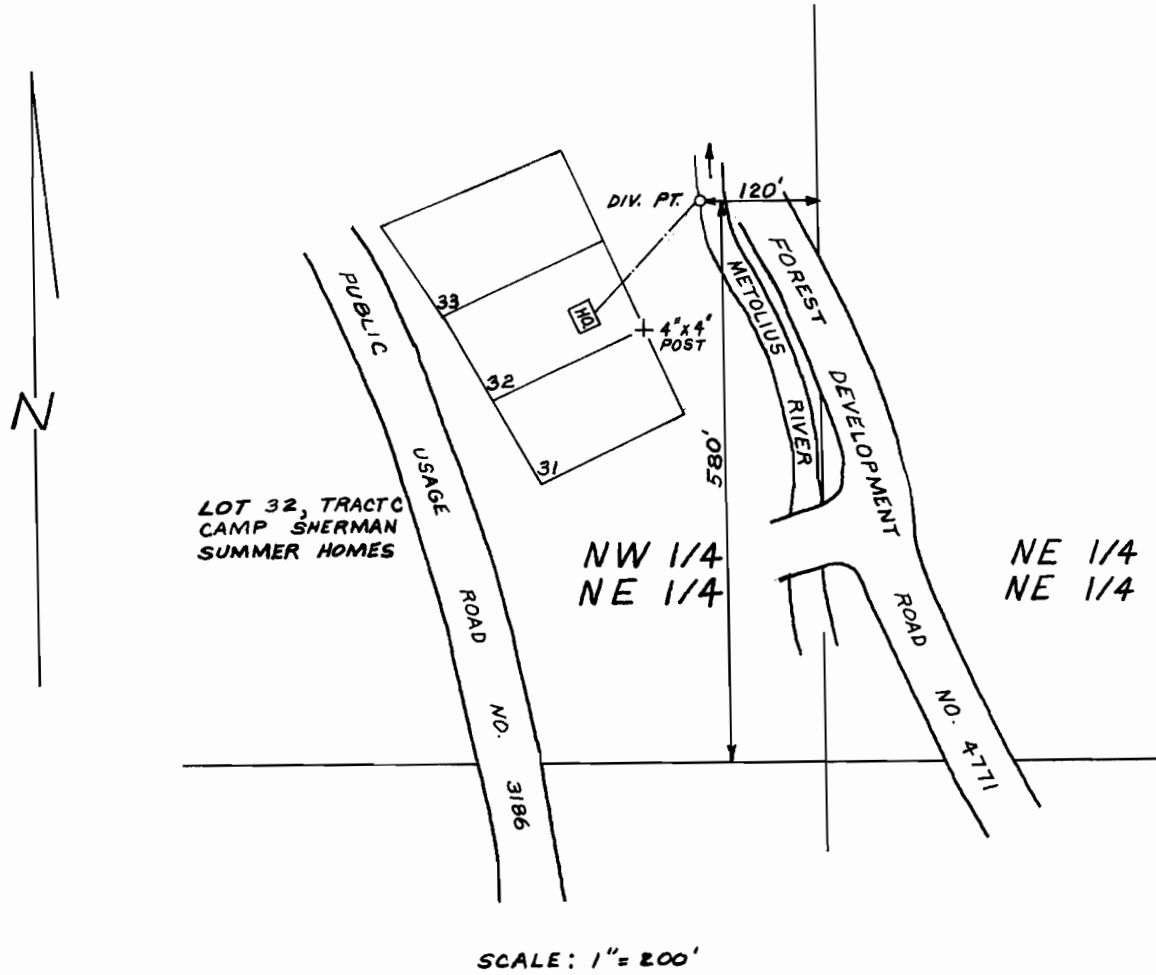

FINAL PROOF SURVEY

UNDER

Application No. 65278 Permit No. 47679

IN NAME OF

GILBERT G. & GLADYS E. TIPTON

Surveyed APRIL 3 19 85, by LESLIE OLSON