


T. 13S., R. 9E., W.M.  
SECTION 10

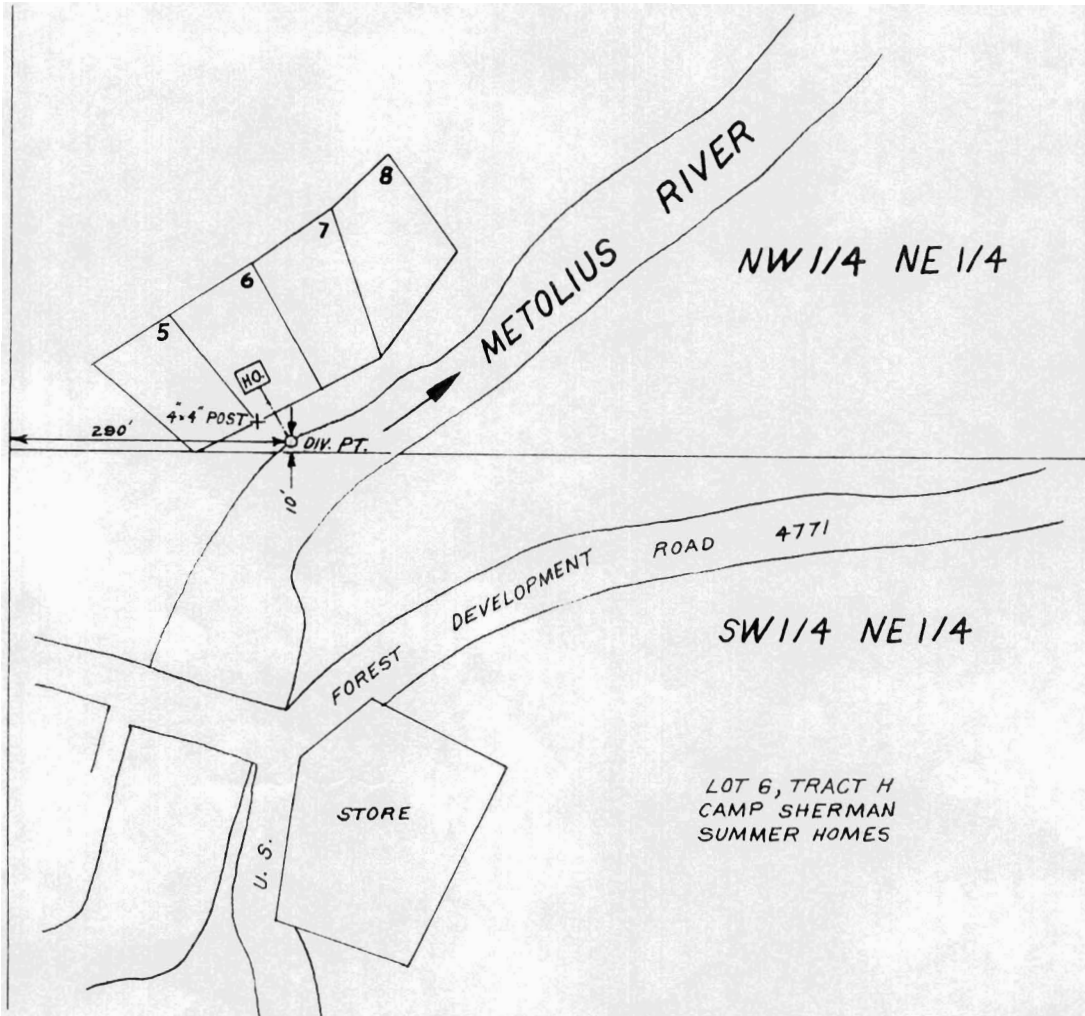

SCALE: 1" = 200'

FINAL PROOF SURVEY

UNDER

Application No. 63755 Permit No. 48312

IN NAME OF

HAROLD D. & CECIL O. EAKIN CERT. # 53337

Surveyed FEB. 28 19 85., by TIM W. BURKS



48312

CHAIN & COMPASS SURVEY