


T. 13 S., R. 9 E., W. M.

SECTION 10

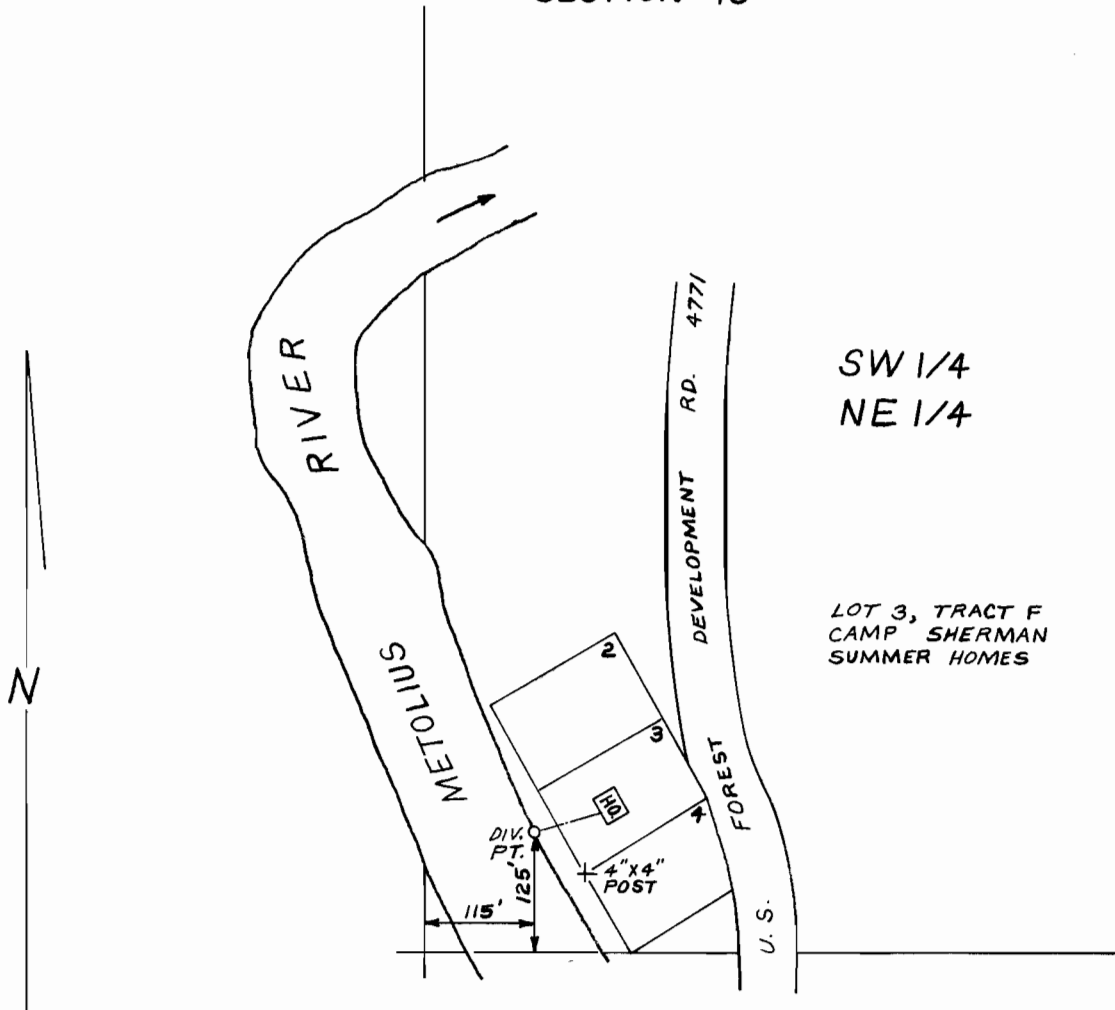

SCALE: 1" = 200'

FINAL PROOF SURVEY

UNDER

Application No. 65310 Permit No. 47689

IN NAME OF

DOUGLAS G. & JOANNE A. RAINES

Surveyed MAY 1, 1985, by LESLIE OLSON