


T. 13 S., R. 9 E., W.M.
SECTIONS 10 & 15

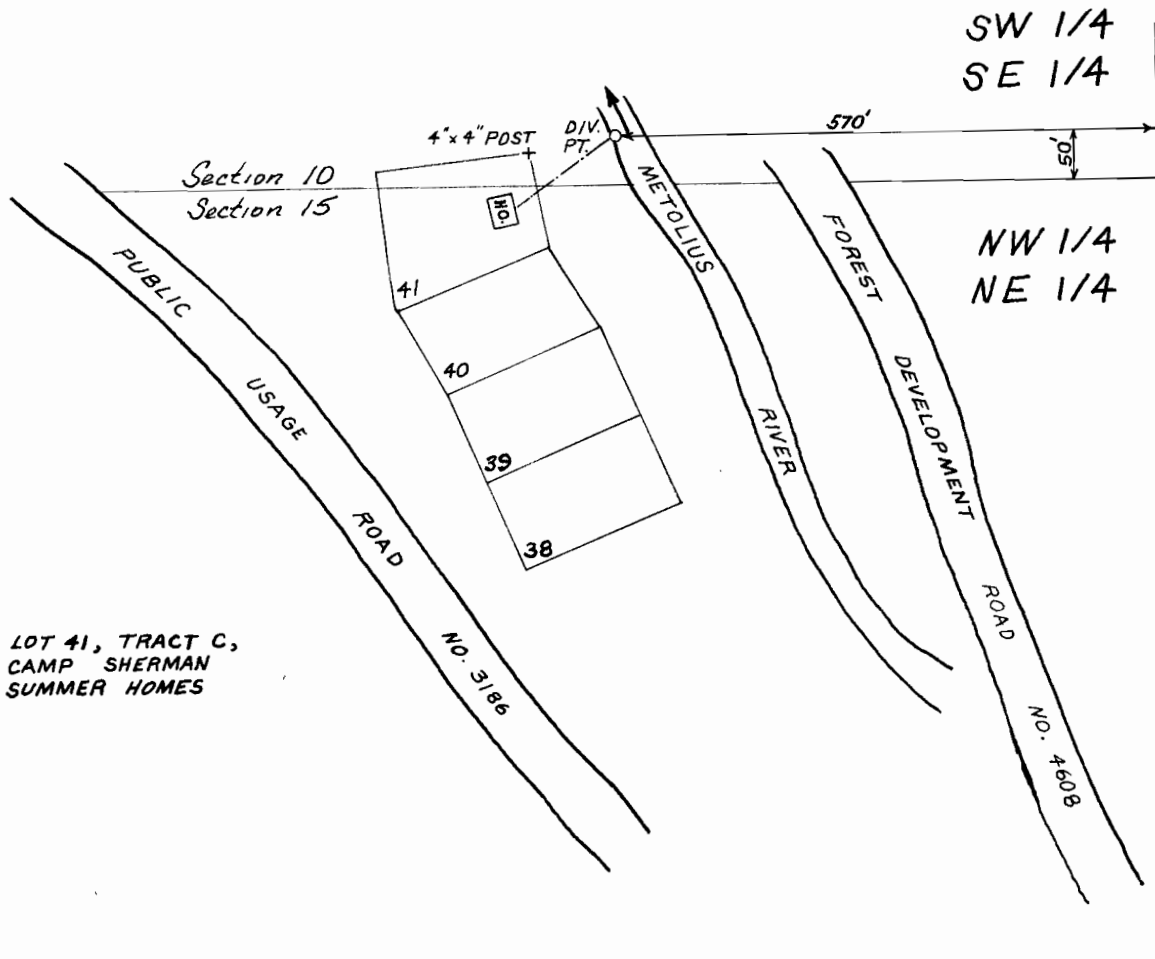

LOT 41, TRACT C,
CAMP SHERMAN
SUMMER HOMES

SCALE: 1" = 200'

FINAL PROOF SURVEY

UNDER

Application No. 65473 Permit No. 47705

IN NAME OF

FRANCIS E. PATRICIA M. BRESLER

Surveyed FEB. 28 19 85., by LESLIE OLSON