


T. 13 S., R. 9 E., W. M.

SECTION 15

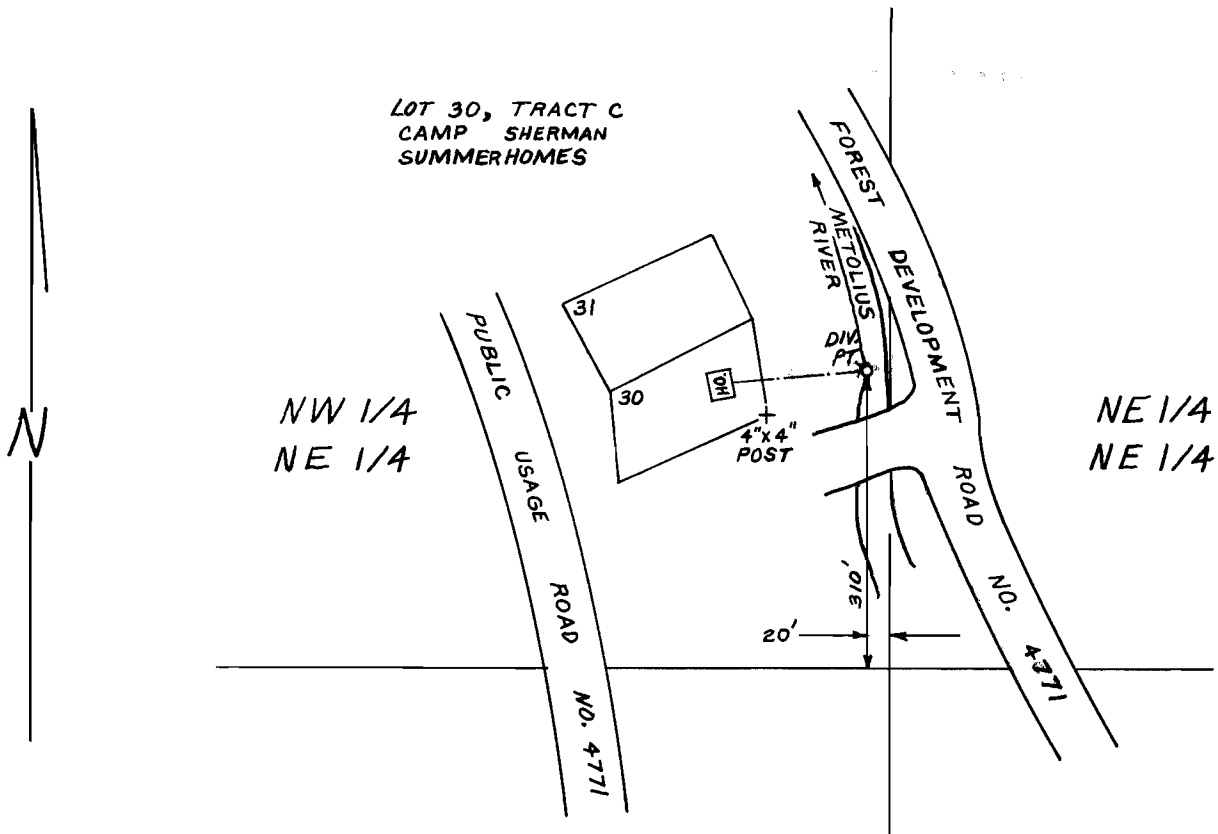

SCALE : 1" = 200'

FINAL PROOF SURVEY

UNDER

Application No. 65311 Permit No. 47690

IN NAME OF

EARL L. & ESTHER M. TRAVIS

Surveyed APRIL 3 19 85, by LESLIE OLSON