


T. 34S., R. 6W., W. M.

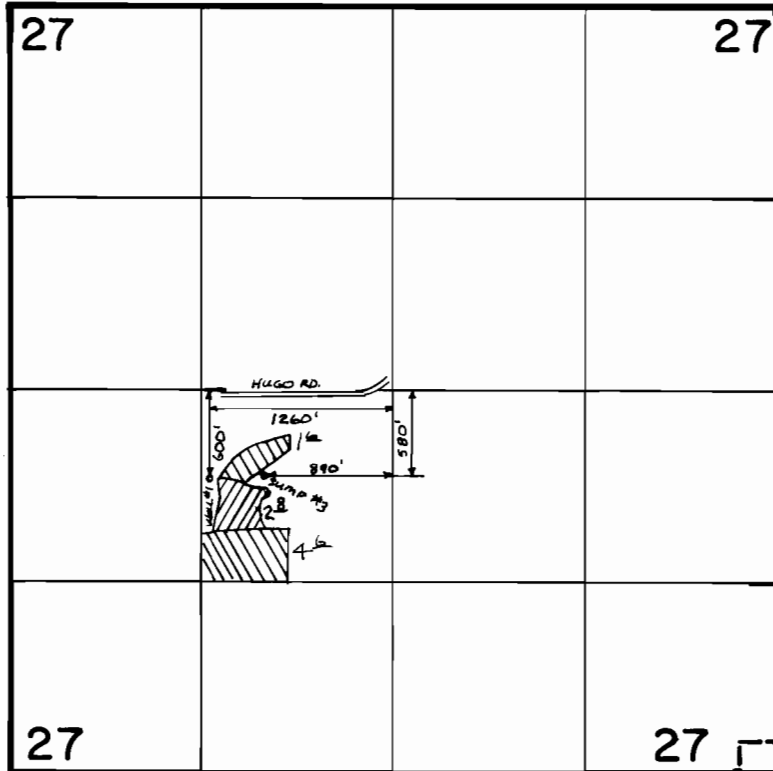

SCALE 1" = 1320'

 IRRIGATED FROM JUMP #3

 IRRIGATED FROM WELL #1

FINAL PROOF SURVEY
UNDER

Application No. G-7037 Permit No. G-6524....
IN NAME OF

WAYNE McKY

Surveyed SEPT. 10 1984, by J. R. WOODROOF