




T.38S.R.8W.W.M.

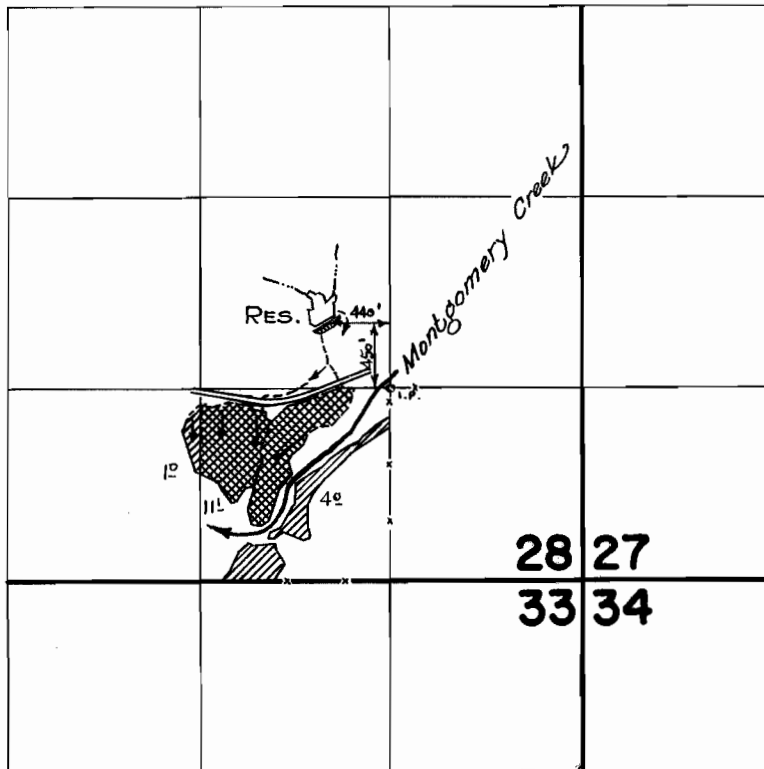

 PRIMARY
 SUPPLEMENTAL

FINAL PROOF SURVEY UNDER

R-37741 R-3085
Application No. 37742 Permit No. 28189
IN NAME OF

TRIANGLE 3 RANCH

Surveyed June 23 1965, by *[Signature]*