


3189517

T. 39 S. R. 5 E. W. M.

53346

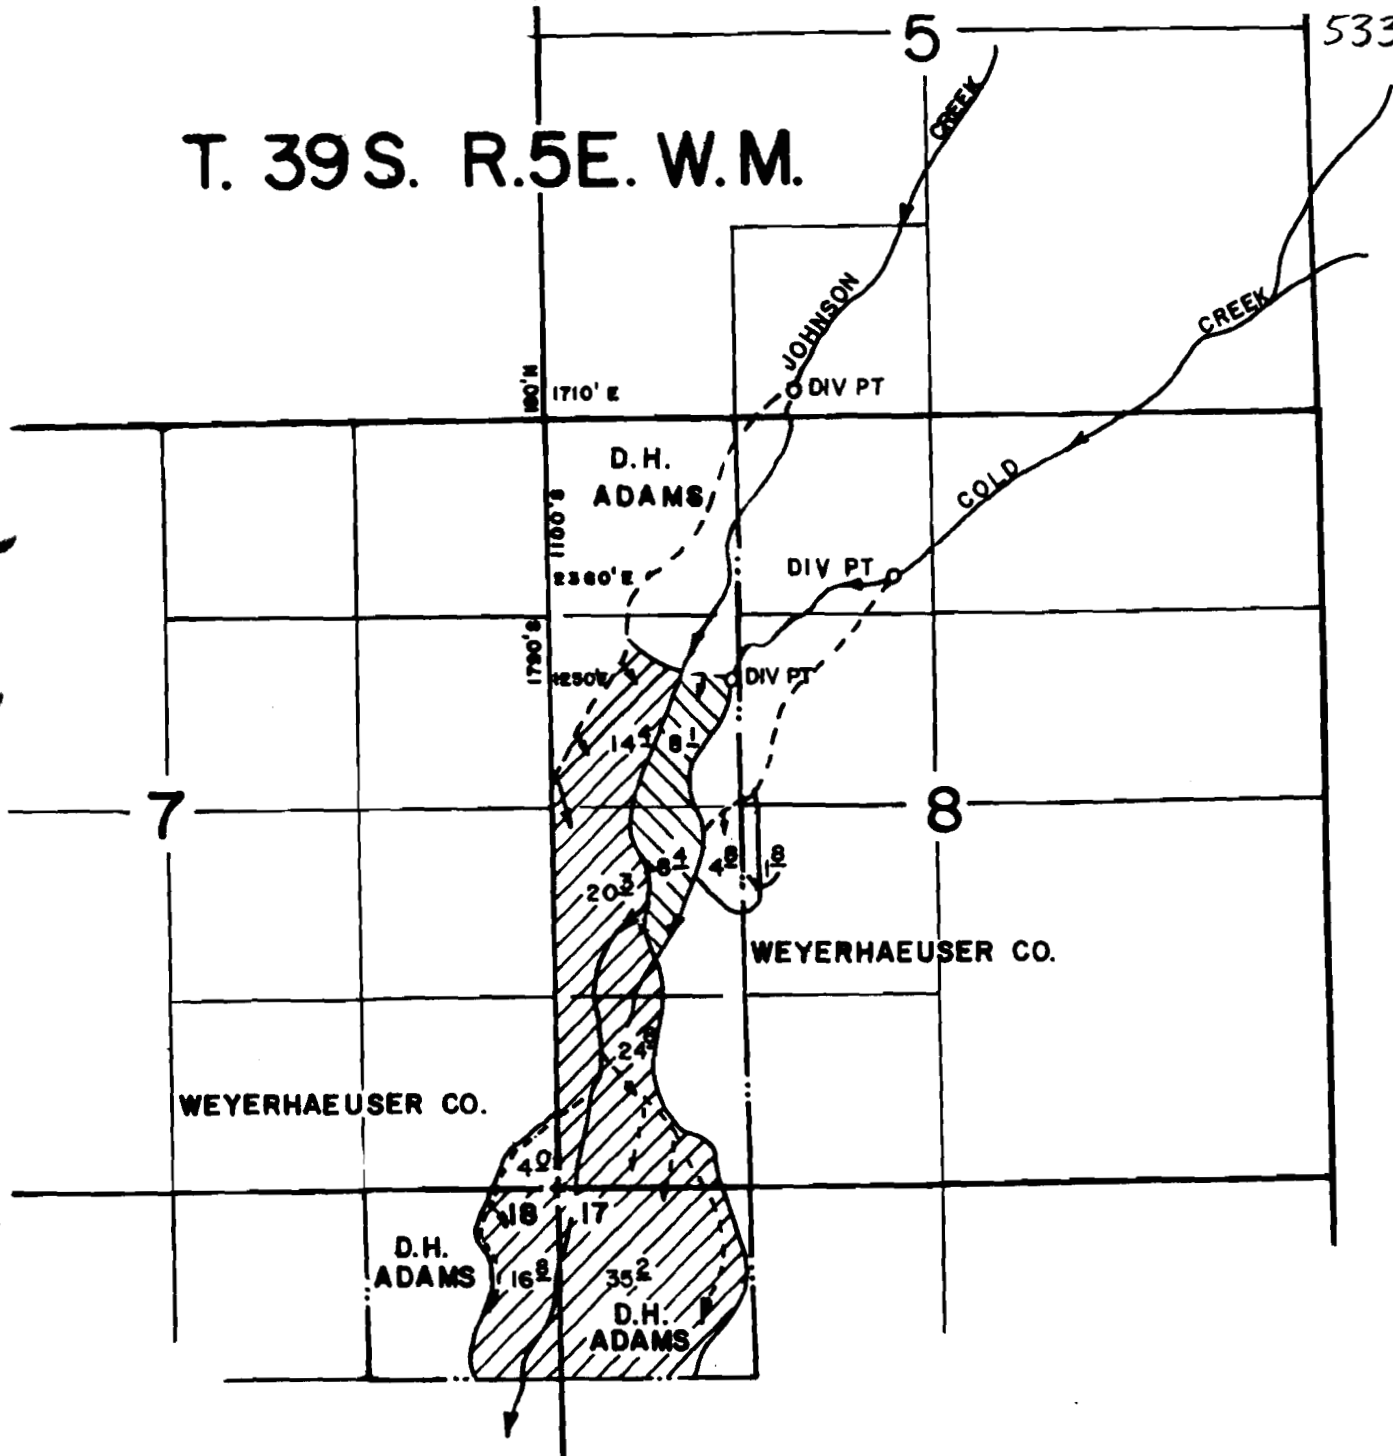

FINAL PROOF SURVEY
UNDER

Application No. 42692... Permit No. 31895.....
IN NAME OF

D. H. & REGINA ADAMS.....

Surveyed NOV 9..... 19 78., by D. KNAUER.....