


G.8330
 G.9203
 T8020
 53348

T.27S. R.17E. W.M.

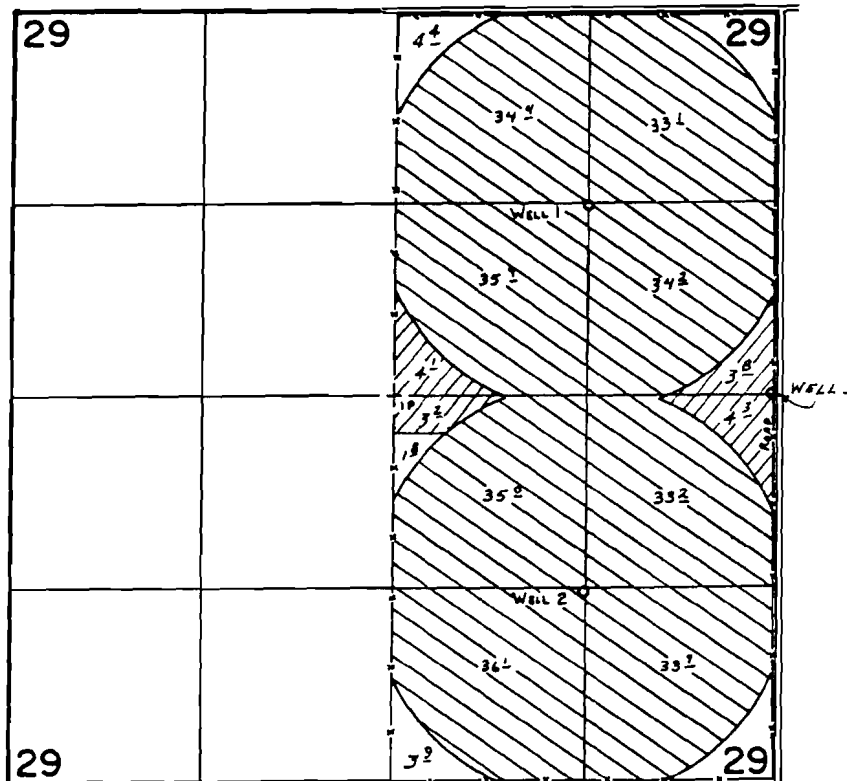

WELLS Loc:
 1- 1300' N. & 1320' E.
 2- 1340' S. & 1310' E.
 3- 2400' E.
 ALL FROM C. 1/4 COR. SEC. 29.

FINAL PROOF SURVEY
 UNDER

G-10132 G-9203
 Application No. ~~G-8924~~ Permit No. ~~G-8330~~
 IN NAME OF

...WILLIAM L. & JANELLE I. BIERMANN...

Surveyed Aug. 24, 1979, by C. L. HUGHES...
 NOV. 1 1984 B. W. BISHOP