


G-9122¹²
53351

T. 26S., R. 19E., W.M.

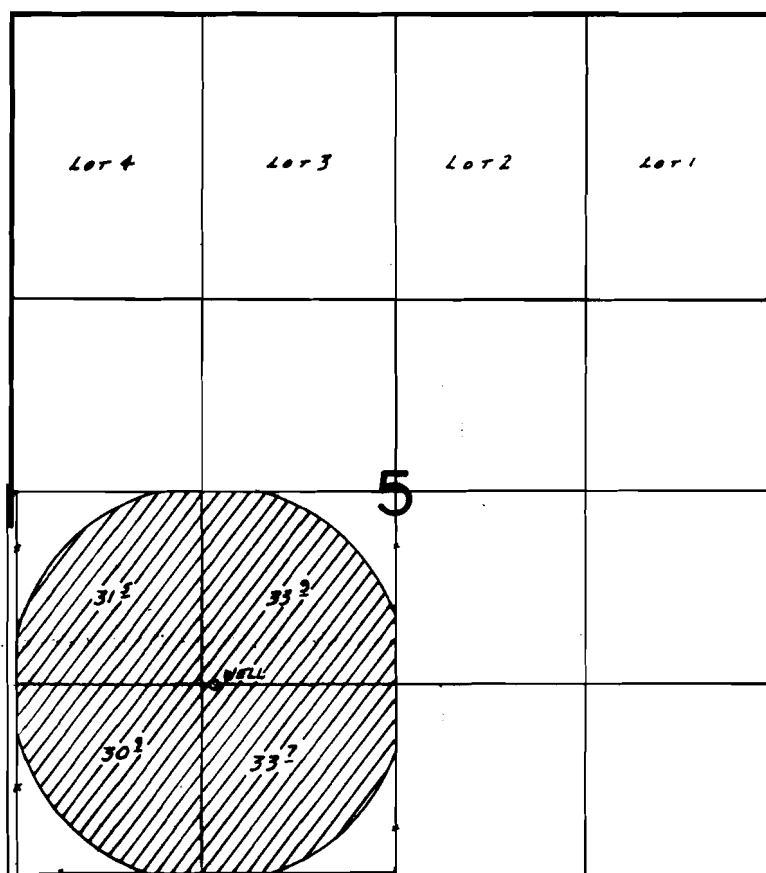

WELL LOC: 1320' W. & 1320' E. FROM SW COR. SEC. 5'

40.15

Scale: 1" = 1320'

FINAL PROOF SURVEY UNDER

Application No. G-10051. Permit No. G-9122.....
IN NAME OF

.....RICHARD MENSCH.....

Surveyed OCT. 16, 1984, by R.W. BISHOP.....