


T.27S.,R.17E.,W.M.

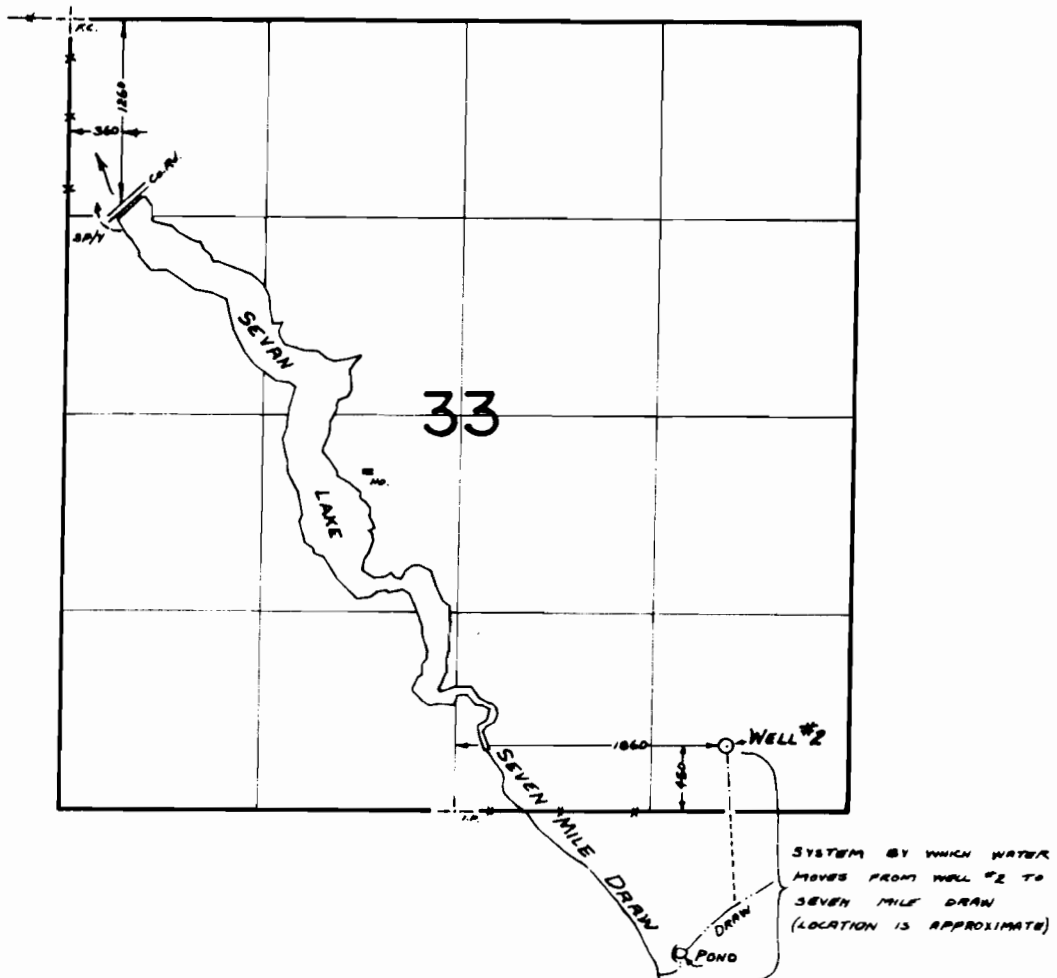

FINAL PROOF SURVEY
UNDER

45540 37541
R-45825 R-6091
Application No. G-5009 Permit No. G-5267.....
IN NAME OF

JOHN A. PETTUS

Surveyed OCT. 22, 1981, by L. TOLL