


G. 5267  
 (R 6091)  
 37541  
 53354

T.27S.,R.17E.,W.M.

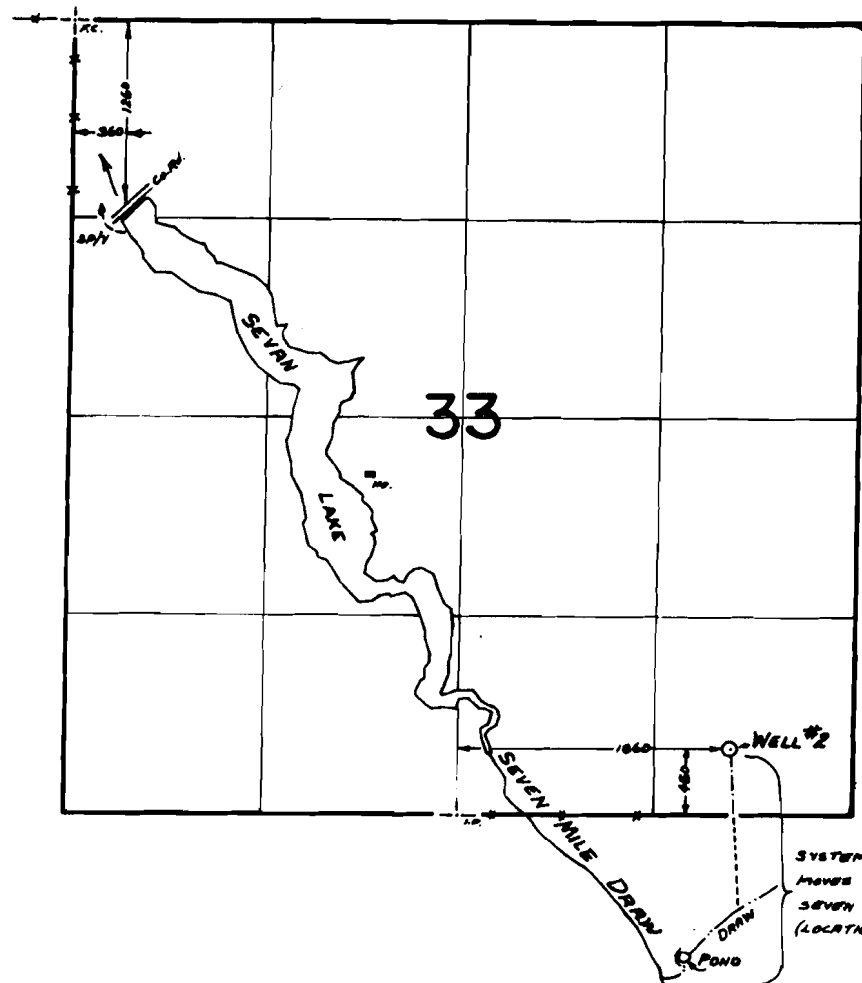

SYSTEM BY WHICH WATER  
 MOVES FROM WELL #2 TO  
 SEVEN MILE DRAIN  
 (LOCATION IS APPROXIMATE)

**FINAL PROOF SURVEY**  
 UNDER

45540                      37541  
 R-45825                  R-6091  
 Application No. G-5009 Permit No. G-5267.....  
 IN NAME OF

JOHN A. PETTUS

Surveyed OCT. 22, 1981, by L. J. L.