




Application No. 57008  
 Permit No. 42880  
 T. 38 S. R. 19 E. W.M.

C-53355  
 cancelled spec. Order  
 V 34 P 493 4-23-81  
 order amending order  
 5-28-85  
 V 39 P. 205

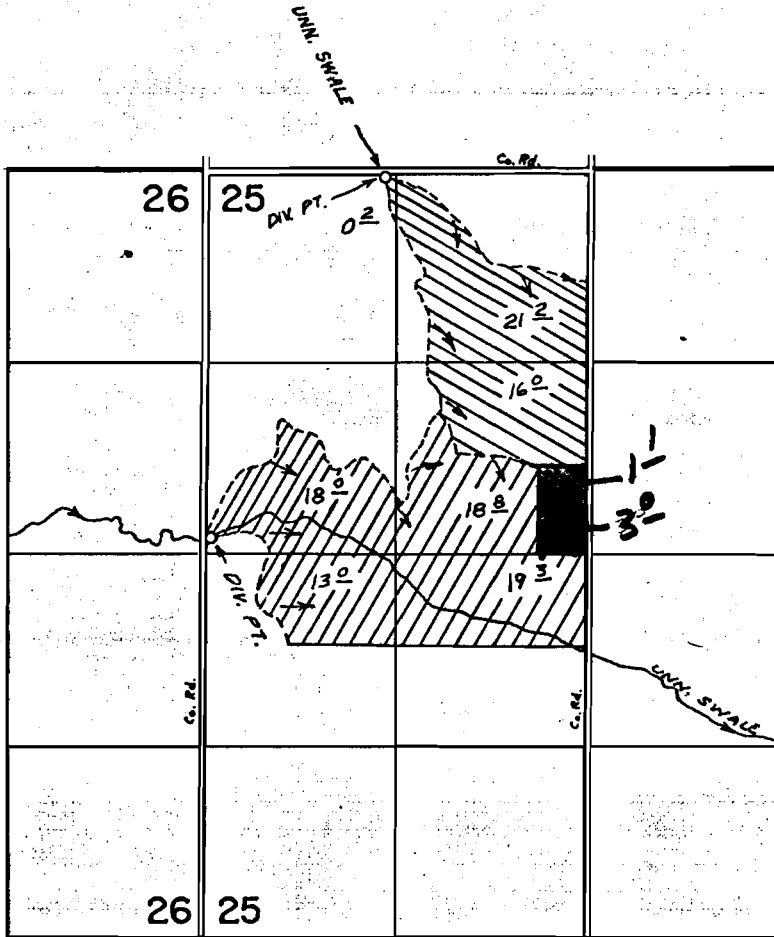

 APP. 45344 DIV. PT. 2540' S & 40' E FROM NW COR. SEC 25  
 APP. 45289 DIV. PT. 20' S & 1220' E. FROM NW COR. SEC. 25

**FINAL PROOF SURVEY**  
 UNDER

Application No. 45289 Permit No. 33818  
45344 Permit No. 33858  
 IN NAME OF  
**L. A. & ALICE E. PIERSON**

Surveyed AUG. 27 1973, by R.G. MUCKEN

JAN 30 1978  
 Filed