


T. 6S., R. 10W., W.M.

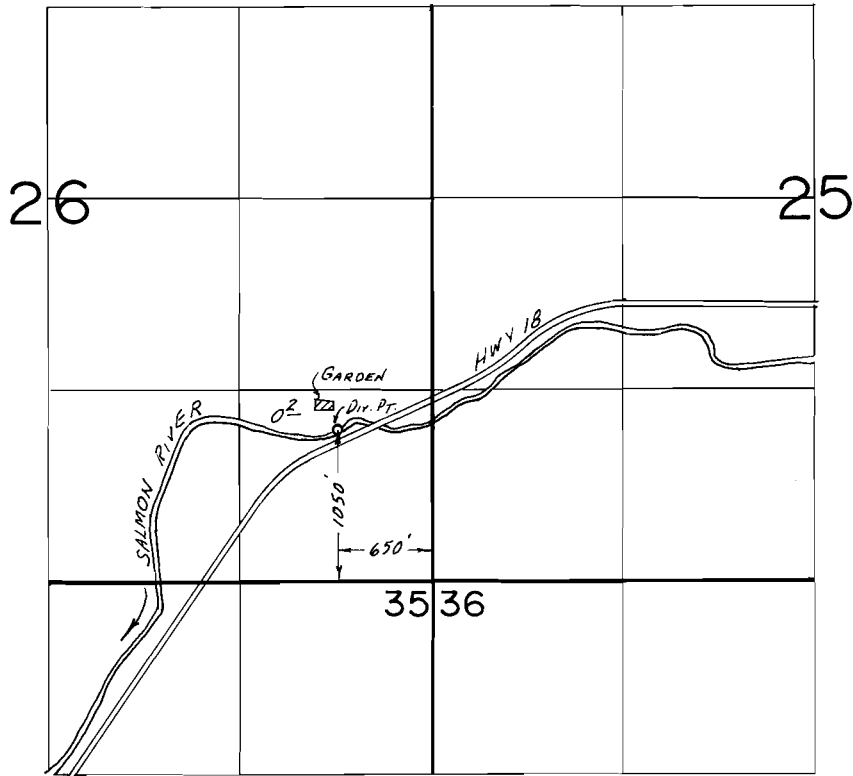

SCALE: 1"=1320'

FINAL PROOF SURVEY UNDER

Application No. 59815... Permit No. 45001.....
IN NAME OF

SAM & HAZEL WEBSTER.....

Surveyed Sept. 13... 19.84, by B.W. BISHOP.....