


T. 13S. R. 1E. W. M.

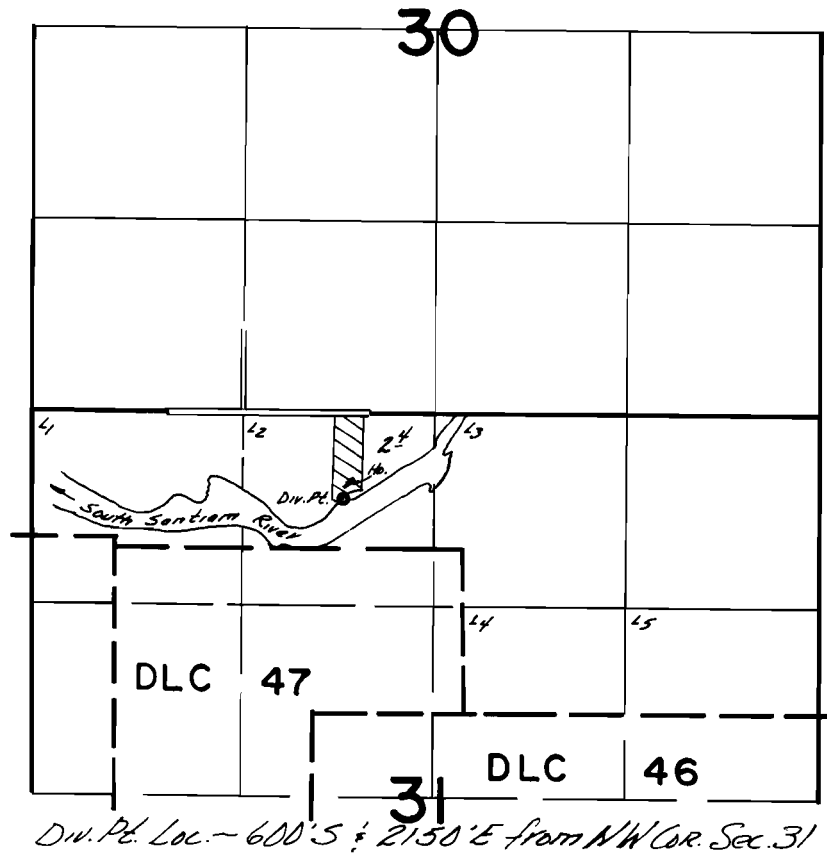

FINAL PROOF SURVEY
UNDER

Application No. 53852. Permit No. 4Q189.....
IN NAME OF

GERALD N. & RUTH I. WRIGHT.....

Surveyed Aug. 1..... 1979, by S.C. BROWN.....