


T.14S.R.1E.W.M.

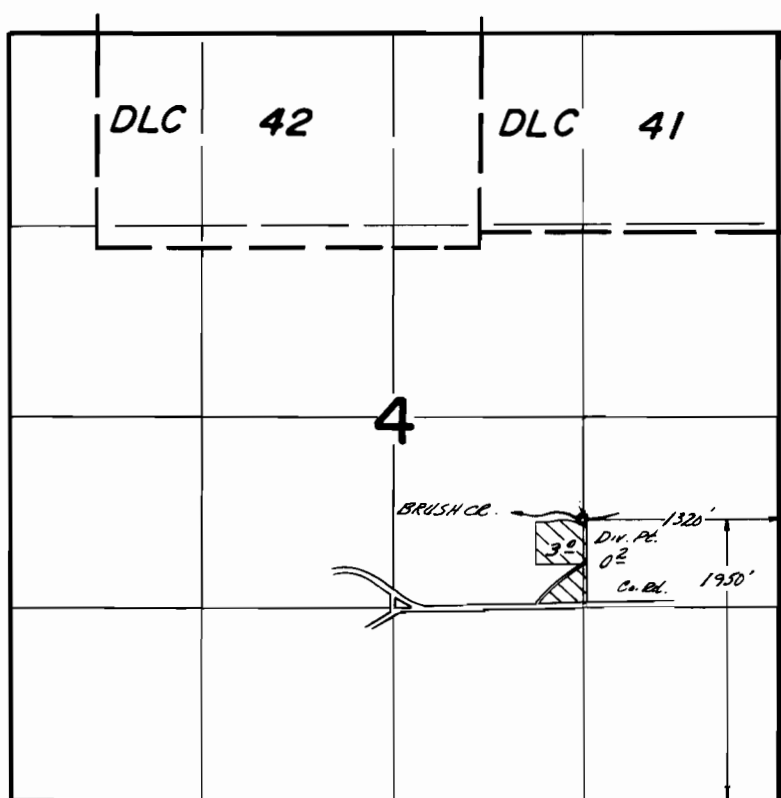

FINAL PROOF SURVEY
UNDER

Application No. 52092 Permit No. 39250.....
IN NAME OF

RICHARD A. COLLINGWOOD.....

Surveyed Aug. 2... 1979., by S.C. BROWN.....