


T.3&4S.,R.1W.,W.M.

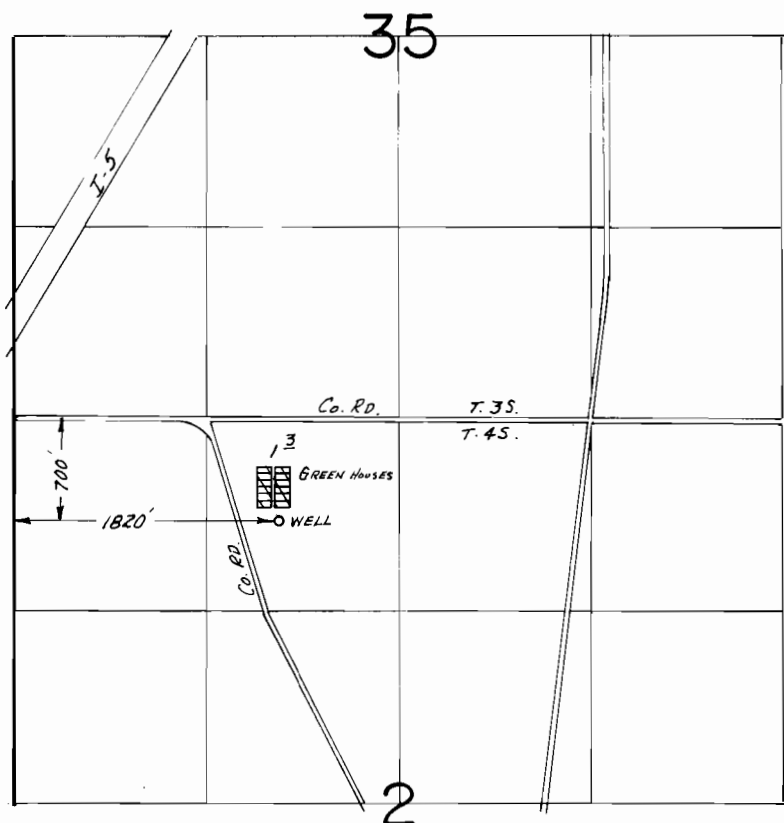

SCALE: 1" = 1320'

FINAL PROOF SURVEY UNDER

Application No. G-6795. Permit No. G-6303.....
IN NAME OF

.....STANLEY V. SHEPHARD.....

Surveyed June 14, 1984, by B.W. BISHOP.....